

MISSISSIPPI DEPARTMENT OF NATURAL RESOURCES

Bureau of Land and Water Resources

Southport Mall

P.O. Box 10631

Jackson, Mississippi 39209

WATER WELL DRILLERS LOG

BUTANE GAS COMPANY

Leflore
P 2001

2-14
date well completed

19*84*

GREENWOOD

Leflore
county well located

LANDOWNER:
Ben Downing
Morgan City
(mailing address)

description of formations encountered	from	to
<i>CLAY</i>	<i>0</i>	<i>35</i>
<i>sand</i>	<i>35</i>	<i>55</i>
<i>sand & gravel</i>	<i>55</i>	<i>100</i>

WELL LOCATION:
sec. *5* T. *17* N. R. *2* W.
3.5 miles *S.W.* of *Morgan City*
(distance) (direction) (nearest town)

WELL PURPOSE: *Chemical*
(home, irrigation, municipal, industrial)

- WELL COMPLETION DATA:
- (1) diameter (inches) *4"*
 - (2) total depth (feet) *100*
 - (3) static water level (feet) *18* (below above top of ground)
 - (4) casing *PVC.* (material), *80* (depth)
4" (size) if telescope see back.
 - (5) screen *20* (length), *80* (depth to top)
4" (size), *PVC.* (material)
 - (6) pump *1 h.p.* (HP), *20* (yield gpm)
Elect. (type power)
 - (7) electric log *No* (yes or no)
No (organization running log)
 - (8) how well bottom plugged *Back Wash Valve*

DRILLERS REMARKS:
Richard Vest


DEPT. OF NATURAL RESOURCES
BUREAU OF LAND & WATER RESOURCES

FEB 21 1984

RECEIVED

If well telescopes please sketch and show depths.

GROUND LEVEL

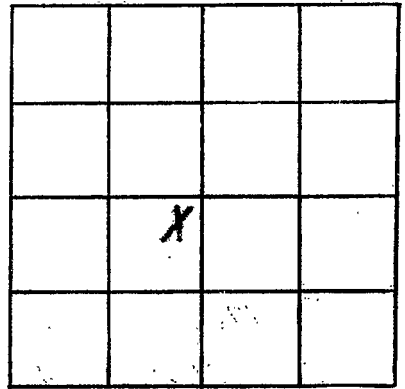

SECTION 3

Please indicate well location X.

ADDITIONAL INFORMATION

If more than one screen,
show locations of each on sketch.