

Leflore
 P 2002
 6-3-77

MISSISSIPPI
 BOARD OF WATER COMMISSIONERS
 416 North State Street
 Jackson, Mississippi 39201

WATER WELL DRILLERS LOG

6-3-77 19 BUTANE GAS CO. OF GREENWOOD Leflore
 date well completed firm name county well located

LANDOWNER:	description of formations encountered	from	to
R. E. Wilson			
Belzoni	SAND	15	60
(mailing address)	SAND & GRAVEL	60	120
WELL LOCATION:	Clay	120	160
sec. 17 T. 17 N R. 2 E	SAND & CLAY	160	260
SW	SAND	260	320
2 1/2 miles NW of Swiftown	Clay	320	440
(distance) (direction) (nearest town)	SAND & SHALE	440	682
WELL PURPOSE: Home	SAND	682	798
(home, irrigation, municipal, industrial)			

- WELL COMPLETION DATA:
- (1) diameter (inches) 4 1/2
 - (2) total depth (feet) 774
 - (3) static water level (feet) 18 below above top of ground.
 - (4) casing Steel, 754
(material) (depth)
4 1/2
(size) If telescope see back.
 - (5) screen 20, 754
(length) (depth to top)
2", Stainless
(size) (material)
 - (6) pump 1, 20
(HP) (yield gpm)
Elec.
(type power)
 - (7) electric log NO
(yes or no)

(organization running log)
 - (8) how well bottom plugged
Back Pressure Valve

RECEIVED
 JUN 26 1977

MISS. BD. OF WATER COMMISSIONERS

DRILLERS REMARKS:


If well telescopes please sketch and show depths.

GROUND LEVEL

105' - 4" CASING →

649' - 2" CASING →

70' - 2" SCREEN →

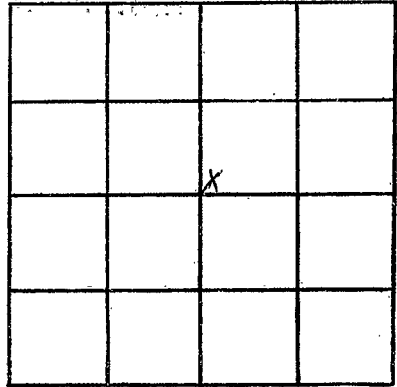

SECTION 17

Please indicate well location X.

ADDITIONAL INFORMATION

If more than one screen, show locations of each on sketch.