

LeFlore  
 P 2004  
 3/6/78

MISSISSIPPI  
 BOARD OF WATER COMMISSIONERS  
 416 North State Street  
 Jackson, Mississippi 39201

WATER WELL DRILLERS LOG  
 BUTANE GAS COMPANY

3/6/78 19 OF GREENWOOD LeFlore county well located

LANDOWNER:  
 Reece MALKAMSON  
 MORGAN City  
 (mailing address)

description of formations encountered	depth	
	from	to
CLAY	0	15
SAND	15	50
SAND + GRAVEL	50	103

WELL LOCATION:  
 sec. 4 T-17 N R-2 W  
 4 1/2 miles SW of MORGAN City  
 (distance) (direction) (nearest town)

WELL PURPOSE: Home  
 (home, irrigation, municipal, industrial)

WELL COMPLETION DATA:

(1) diameter (inches) 4"

(2) total depth (feet) 100

(3) static water level (feet) 18 below top of ground.

(4) casing PVC 80 (material) (depth)  
 4" if telescope see back. (size)

(5) screen 20 80 (length) (depth to top)  
 4" PVC (size) (material)

(6) pump 1 1/2 40 (HP) (yield gpm)  
 Elec. (type power)

(7) electric log NO (yes or no)

(organization running log)

(8) how well bottom plugged  
 Back Pressure Valve


DRILLERS REMARKS:

RECEIVED  
 MAR 21 1978

MISS. BD. OF WATER COMMISSIONERS

If well telescopes please sketch and show depths.

GROUND LEVEL

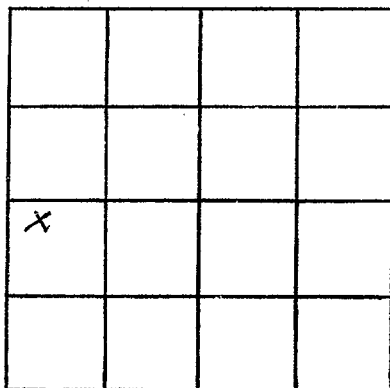

SECTION 4

Please indicate well location X.

ADDITIONAL INFORMATION

If more than one screen,  
show locations of each on sketch.