

*Leflore*  
 2006  
 11-5-76

MISSISSIPPI  
 BOARD OF WATER COMMISSIONERS  
 416 North State Street  
 155 Jackson, Mississippi 39201

WATER WELL DRILLERS LOG

11-5-76 19 BUTANE GAS CO. OF GREENWOOD *Leflore*  
 date well completed firm name county well located

LANDOWNER:	description of formations encountered	from	to
<i>William Bradford</i>			
<i>MORGAN City</i> (mailing address)	<i>SAND-GRAVEL-Clay</i>	<i>60</i>	<i>105</i>
WELL LOCATION:	<i>Clay</i>	<i>105</i>	<i>140</i>
sec. <i>10</i> T. <i>17</i> N. R. <i>2</i> E	<i>SAND</i>	<i>140</i>	<i>260</i>
<i>3</i> miles <i>SW</i> of <i>MORGAN City</i>	<i>Clay</i>	<i>260</i>	<i>440</i>
(distance) (direction) (nearest town)	<i>SAND</i>	<i>440</i>	<i>660</i>
WELL PURPOSE: <i>Home</i>	<i>Clay</i>	<i>660</i>	<i>750</i>
(home, irrigation, municipal, industrial)	<i>SAND + Shale - Rock</i>	<i>750</i>	<i>1040</i>
WELL COMPLETION DATA:	<i>SAND + S. Shale</i>	<i>1040</i>	<i>1155</i>
(1) diameter (inches) <i>4 X 2</i>	<i>Clay</i>	<i>1155</i>	<i>1250</i>
(2) total depth (feet) <i>1322</i>	<i>White Sand</i>	<i>1250</i>	<i>1334</i>
(3) static water level (feet) <i>20</i> <sup>below</sup> above top of ground.			
(4) casing <i>Steel</i> , <i>1302</i> (depth)			
<i>4 X 2</i> (size) if telescope see back.			
(5) screen <i>20'</i> (length), <i>1302</i> (depth to top)			
<i>2"</i> (size), <i>Stainless</i> (material)			
(6) pump <i>1</i> (HP), <i>20</i> (yield gpm)			
<i>Elec.</i> (type power)			
(7) electric log <i>NO</i> (yes or no)			
(organization running log)			
(8) how well bottom plugged <i>Lead Plug</i>			
DRILLERS REMARKS:			

**RECEIVED**  
 NOV - 8 1976  
 MISS. BO. OF WATER COMMISSIONERS


If well telescopes please sketch and show depths.

GROUND LEVEL

105' - 4" CASING →

1197' - 2" CASING →

20' - 2" SCREEN →

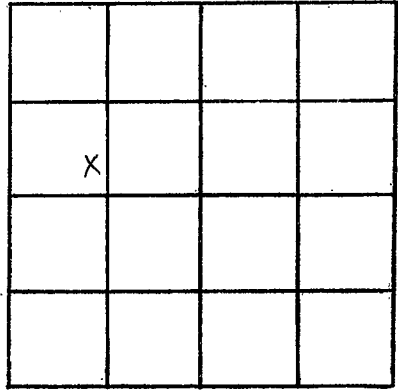

SECTION 10

Please indicate well location X.

ADDITIONAL INFORMATION

If more than one screen, show locations of each on sketch.