

Leflore
 P 2007
 5-4-76

MISSISSIPPI
 BOARD OF WATER COMMISSIONERS
 416 North State Street
 155 Jackson, Mississippi 39201
 WATER WELL DRILLERS LOG


5-4-76 date well completed
 BUTANE GAS CO. OF GREENWOOD firm name
 Leflore county well located

LANDOWNER:	description of formations encountered	from	to
PUGH City Flying Service			
Swift Town	SAND	18	68
(mailing address)	SAND + GRAVEL	68	98
WELL LOCATION:			
sec. 32 T. 17 N. R. 2 E. W. 1			
1 miles S of Swift Town			
WELL PURPOSE: End (home, irrigation, municipal, industrial)			
WELL COMPLETION DATA:			
(1) diameter (inches) 4"			
(2) total depth (feet) 90			
(3) static water level (feet) 18 below top of ground.			
(4) casing PVC, 70 (material), (depth)			
4" (size) if telescope see back.			
(5) screen 20', 70 (length), (depth to top)			
4" PVC (size), (material)			
(6) pump (HP) (yield gpm)			
(type power)			
(7) electric log (yes or no)			
(organization running log)			
(8) how well bottom plugged BACK PRESSURE VALVE			
DRILLERS REMARKS:			

MAY 24 1976
 MISSISSIPPI BOARD OF WATER COMMISSIONERS

If well telescopes please sketch and show depths.

GROUND LEVEL

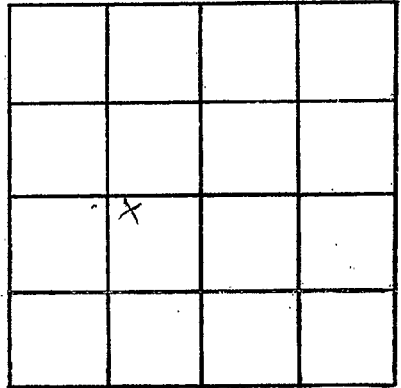

SECTION 32

Please indicate well location X.

ADDITIONAL INFORMATION

If more than one screen,
show locations of each on sketch.