

LEFLORE
P 2008
5/3/76

MISSISSIPPI
BOARD OF WATER COMMISSIONERS
 416 North State Street
 15th Jackson, Mississippi 39201

WATER WELL DRILLERS LOG

5/3/76 19 BUTANE GAS CO. OF GREENWOOD Leflore
 date well completed firm name county well located


LANDOWNER:	description of formations encountered	from	to
<u>E. A. Maxey</u>			
<u>Swiftown</u> (mailing address)	<u>SAND</u>	<u>15</u>	<u>55</u>
WELL LOCATION:	<u>GRAVEL</u>	<u>55</u>	<u>125</u>
sec. <u>29</u> T <u>17</u> N R. <u>2</u> E	<u>CLAY</u>	<u>125</u>	<u>130</u>
S. <u>5</u> W	<u>SAND</u>	<u>130</u>	<u>160</u>
in _____ miles of <u>Swiftown</u>	<u>SANDY SHALE</u>	<u>160</u>	<u>285</u>
(distance) (direction) (nearest town)	<u>SAND</u>	<u>285</u>	<u>370</u>
WELL PURPOSE: <u>Home</u>	<u>SAND + SHALE</u>	<u>370</u>	<u>412</u>
(home, irrigation, municipal, industrial)	<u>SHALE</u>	<u>412</u>	<u>561</u>
WELL COMPLETION DATA:	<u>SANDY SHALE</u>	<u>561</u>	<u>653</u>
(1) diameter (inches) <u>2"</u>	<u>SAND</u>	<u>653</u>	<u>695</u>
(2) total depth (feet) <u>692</u>	<u>CLAY</u>	<u>695</u>	<u>715</u>
(3) static water level (feet) <u>12</u> below above- top of ground.			
(4) casing <u>Steel</u> , <u>672</u> , (material) (depth)			
<u>2"</u> If telescope see back. (size)			
(5) screen <u>20'</u> , <u>672</u> (length) (depth to top)			
<u>2"</u> , <u>STAINLESS</u> (size) (material)			
(6) pump <u>1/2</u> , <u>10</u> (HP) (yield gpm)			
<u>Elec.</u> (type power)			
(7) electric log <u>No</u> (yes or no)			
(organization running log)			
(8) how well bottom plugged <u>Back Pressure Valve</u>			
DRILLERS REMARKS:			

DECE
1976
MAY 13 1976

MISS. RD. OF WATER COMM.

If well telescopes please sketch and show depths.

GROUND LEVEL

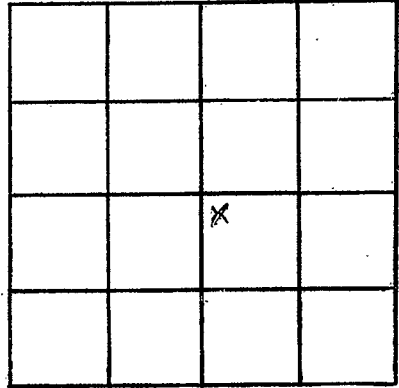

SECTION 29

Please indicate well location X.

ADDITIONAL INFORMATION

If more than one screen,
show locations of each on sketch.