

MISSISSIPPI DEPARTMENT OF ENVIRONMENTAL QUALITY

Office of Land and Water Resources

P. O. Box 10631
Jackson, MS 39289-0631
WATER WELL DRILLERS LOG

COUNTY WELL LOCATED Leflore	
WELL NUMBER P 2019	CODED
DATE WELL COMPLETED 7-23-96	

PERMIT NUMBER
NAME OF DRILLING FIRM Irrigation Equipment
Indianola, MS38751

NAME & MAILING ADDRESS OF LANDOWNER South Fresh Fish Farm		
Box 848		
Indianola, MS 38751		
WELL LOCATION: SEC	TOWNSHIP	RANGE
14	17N	2W
DISTANCE		DIRECTION
3 Miles		SW
NEAREST TOWN Morgan City		
OTHER LANDMARK		
WELL PURPOSE: Home, Irrigation, Municipal, Industrial, Fish Pond, etc. Fish Pond		

PUMP DATA		
PUMP TYPE (Circle One): Submersible, <u>Turbine</u> Jet Flowing Well, Other (Describe)		
POWER TYPE (Circle One): <u>Electric</u> , Tractor, Diesel, Gasoline, <u>60</u> Butane, Other (Describe) H/P		
Pump Capacity (GPM) 3000	No. of Stages 1	Setting Depth 70 FT.
PUMP TEST		
Well yielded _____ GPM with a drawdown of _____ ft. after _____ hours of pumping		

WELL DATA		
Well Depth 117	Casing Diameter (In.) 16	Casing Length (Ft.) 77
Type of Casing Steel	Hole Depth 117	Depth to Static Water Level est. 30ft.
TYPE OF COMPLETION: (Circle One or More): <u>Gravel Packed</u> , Underreamed, Telescoped, Natural Development, Open Hole, Other (Describe)		

LOG DATA	
TYPE OF LOG RUN (Circle One): No Log Run, Electric, Gamma Ray, Density, Sonic, Neutron, Other (Describe)	
Name of Organization Running Log	

WELL GROUTED TO A DEPTH OF _____ FEET
Type Grout (circle one): Cement, Bentonite, or Mix

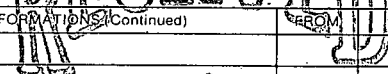
GEOLOGIC DATA (Office Use Only)			
Surface Elev.	Geologic Unit	Unit Thickness	Depth to Top
Subs. SWL	Date	Analysis	Aquifer Test

SCREEN DATA		
Diameter - Inches 16	Length - Feet 40	Slot Size - Inches .060
Screen Type Steel	Depth to Bottom - Feet 117	

Driller's Remarks

Top of Lap Pipe or Reduction in Casing

DESCRIPTION OF FORMATIONS ENCOUNTERED	FROM	TO
Clay	0	35
Fine Sand	35	45
Fine Sand & Gravel	45	70
Med. Sand & Gravel	70	81
Fine Sand & Gravel	81	90
Med. Sand & Gravel	90	117

	
FORMATIONS (Continued)	FROM TO
DEC 09 1993	
Dept. of Environmental Quality Office of Land & Water Resources	
IF MORE SPACE IS NEEDED, USE BACK	

If well telescopes please sketch and show depths.

GROUND LEVEL

x			

SECTION 14

Please indicate well location X.

ADDITIONAL INFORMATION

If more than one screen,
show location of each on sketch.