

MISSISSIPPI
BOARD OF WATER COMMISSIONERS
416 North State Street
Jackson, Mississippi 39201

WATER WELL DRILLERS LOG

Lincoln

Lincoln
A3
4-67 CODED

5-67 19 Fitzgerald Water Well ~~Lincoln~~
date well completed firm name county well located

LANDOWNER: Ed. Buis
Rt 1 Union Church

description of formations encountered

from to

(mailing address)

WELL LOCATION:

sec. 28 T 8 N ✓ R 5 E ✓
S W
20 miles W of Brookhaven
(distance) (direction) (nearest town)

Red sand 0 12
Chalk 12 35
Sand 35 35
White Chalk 65 90
Sand gravel 90 190

WELL PURPOSE:

(home, irrigation, municipal, industrial)

WELL COMPLETION DATA:


- (1) diameter (inches) 4 1/4
(2) total depth (feet) 114
(3) static water level (feet) 75 below top of ground.
(4) casing plastic, 106,
(material) (depth)
4 if telescope see back.
(size)
(5) screen 8", 106
(length) (depth to top)
4, plastic
(size) (material)
(6) pump 1/2, sub 10
(HP) (yield gpm)
elec
(type power)
(7) electric log No
(yes or no)

CODEL

(organization running log)

(8) how well bottom plugged Wood peg

DRILLERS REMARKS:

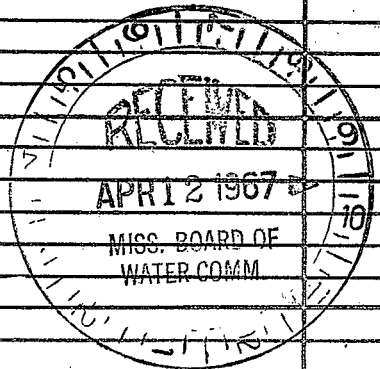

CODED

CODED

CODED

If well telescopes please sketch and show depths.

CODED

GROUND LEVEL

CODED

CODED

X			

SECTION 28

Please indicate well location X.

ADDITIONAL INFORMATION

If more than one screen, show locations of each on sketch.