

MISSISSIPPI
BOARD OF WATER COMMISSIONERS
416 North State Street
Jackson, Mississippi 39201

Lincoln
A4
10-22-69

INDEXED

WATER WELL DRILLERS LOG

October 22, 1969 date well completed
Kenes well drillers firm name
Lincoln county well located

LANDOWNER	description of formations encountered	from	to
John Pritchard Rt-1, Union Church (mailing address)	Brown clay	0	12
	Coarse sand	12	25

WELL LOCATION:
sec. 8 T. 8 N. R. 5 E
4 miles ESE of Union Church
(distance) (direction) (nearest town)

fine white sand	25	25
Coarse sand	55	61

WELL PURPOSE: Home
(home, irrigation, municipal, industrial)

WELL COMPLETION DATA:
(1) diameter (inches) 4"
(2) total depth (feet) 61
(3) static water level (feet) 21 below top of ground.
(4) casing Plastic bottom
(material) (depth)
 if telescope see back.
(size)
(5) screen 6' 55'
(length) (depth to top)
4" Plastic
(size) (material)
(6) pump 1/2 HP 15
(HP) (yield gpm)
elect
(type power)
(7) electric log no
(yes or no)

(organization running log)

INDEXED

(8) how well bottom plugged
wooden plug


DRILLERS REMARKS:
old well hole

DEC 31 1969

MISS. Bd. of
WATER COMMISSIONERS

If well telescopes please sketch and show depths.

GROUND LEVEL

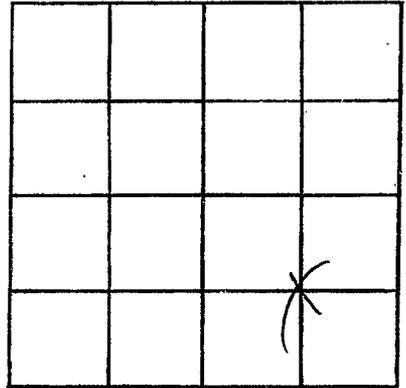

SECTION 4

Please indicate well location X.

ADDITIONAL INFORMATION

If more than one screen,
show locations of each on sketch.