

MISSISSIPPI  
BOARD OF WATER COMMISSIONERS  
416 North State Street  
Jackson, Mississippi 39201

**CODED**

WATER WELL DRILLERS LOG

LINCOLN  
AS  
8-1-70

8-1  
date well completed

1970 *Fitzgerald Well Dr*  
firm name

*Lincoln*  
county well located

LANDOWNER:  
*Henry Pierce*  
*R.R. Caseyville, Miss.*  
(mailing address)

description of formations encountered	from	to
<i>Red clay</i>	<i>0</i>	<i>20</i>
<i>Red sand</i>	<i>20</i>	<i>90</i>
<i>white chalk</i>	<i>90</i>	<i>140</i>
<i>fine sand</i>	<i>140</i>	<i>160</i>
<i>Coarse sand</i>	<i>160</i>	<i>176</i>

WELL LOCATION:  
sec. 14 T. 8 N. R. 5 E  
*2* miles *W* of *Caseyville*  
(distance) (direction) (nearest town)

WELL PURPOSE: *Home*  
(home, irrigation, municipal, industrial)

- WELL COMPLETION DATA:
- (1) diameter (inches) 4
  - (2) total depth (feet) 176
  - (3) static water level (feet) 120 below above top of ground.
  - (4) casing *plastic*, 170,  
(material) (depth)  
4 If telescope see back.  
(size)
  - (5) screen 6, 170  
(length) (depth to top)  
4, *plastic*  
(size) (material)
  - (6) pump 1/2 10  
(HP) (yield gpm)  
*Elan*  
(type power)
  - (7) electric log *no*  
(yes or no)  
*Woodpe*  
(organization running log)
  - (8) how well bottom plugged *Woodpe*

**CODED**


AUG 17 1970

DRILLERS REMARKS:

MISS. RE. WATER

If well telescopes please sketch and show depths.

GROUND LEVEL

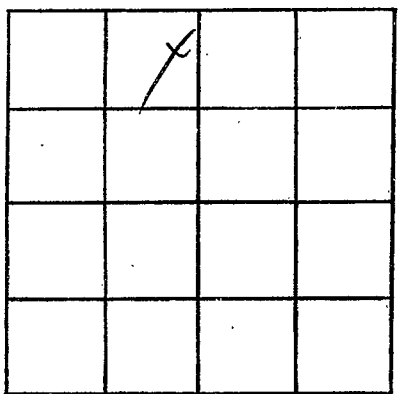

SECTION 14

Please indicate well location X.

ADDITIONAL INFORMATION

Lined area for additional information.

If more than one screen, show locations of each on sketch.