

LINCOLN
A7
5-20-74

MISSISSIPPI
 BOARD OF WATER COMMISSIONERS
 416 North State Street
 Jackson, Mississippi 39201

CODED

WATER WELL DRILLERS LOG

May 20, 1974 Grenn Water well Cont. Lincoln
 date well completed firm name county well located


LANDOWNER:	description of fomations encountered	from	to
Charles Case Rt. 1, Box 267 Wesson, Miss. (mailing address)	Citronelle	0	146
WELL LOCATION: sec. 12 T 8 R 5 13 miles NW of Brookhaven (distance) (direction) (nearest town)			
WELL PURPOSE: home (home, irrigation, municipal, industrial)			
WELL COMPLETION DATA: (1) diameter (inches) 6" (2) total depth (feet) 146 (3) static water level (feet) 90 below top of ground. (4) casing PVC 140 (material) (depth) 4" (size) If telescope see back. (5) screen 6' 140' (length) (depth to top) .010 PVC (size) (material) (6) pump 1/2 sub 7 (HP) (yield gpm) electric (type power) (7) electric log no (yes or no) (organization running log) (8) how well bottom plugged wood			
DRILLERS REMARKS:			

CODED

RECORDED
 INDEXED
 JUN 6 1974
 MISS. Bd. of

If well telescopes please sketch and show depths.

GROUND LEVEL

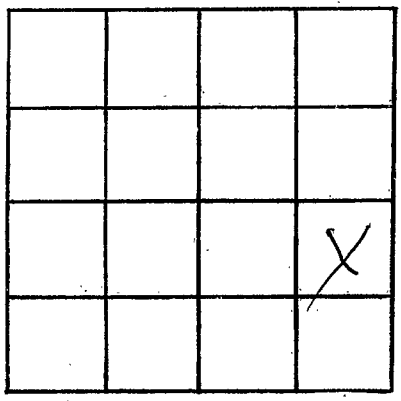

SECTION 12

Please indicate well location X.

ADDITIONAL INFORMATION

A series of horizontal lines for writing additional information.

If more than one screen, show locations of each on sketch.