

CODED

CODED

Lincoln  
A 9  
6-16-25

MISSISSIPPI  
BOARD OF WATER COMMISSIONERS  
416 North State Street  
Jackson, Mississippi 39201

WATER WELL DRILLERS LOG

June 16 1975 Reynolds Well Drilling Lincoln  
date well completed firm name county well located

LANDOWNER:  
Laymore Scott  
Rt. Brookhaven  
(mailing address)

| description of formations encountered | from       | to         |
|---------------------------------------|------------|------------|
| <u>Red Clay</u>                       | <u>0</u>   | <u>20</u>  |
| <u>sand &amp; gravel</u>              | <u>20</u>  | <u>76</u>  |
| <u>White Chalk</u>                    | <u>76</u>  | <u>112</u> |
| <u>fine white sand</u>                | <u>112</u> | <u>126</u> |
| <u>med. coarse sand</u>               | <u>126</u> | <u>135</u> |

WELL LOCATION:  
sec. 11 T 8 N R 5 E  
2 miles West of Conville  
(distance) (direction) (nearest town)

WELL PURPOSE: Private  
(home, irrigation, municipal, industrial)

- WELL COMPLETION DATA:
- (1) diameter (inches) 4"
  - (2) total depth (feet) 135
  - (3) static water level (feet) 116 below top of ground.
  - (4) casing plastic (material) bottom (depth)
  - (5) screen 6" (length) 129 (depth to top)  
4' (size) plastic (material)
  - (6) pump 1/2 (HP) 10 (yield gpm)  
elect (type power)
  - (7) electric log no (yes or no)
- (organization running log)


(8) how well bottom plugged wooden plug

DRILLERS REMARKS:  
new house site

RECEIVED  
SEP - 8 1975

If well telescopes please sketch and show depths.

GROUND LEVEL

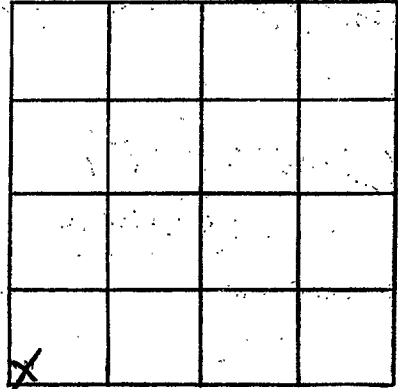

SECTION 11

Please indicate well location X.

ADDITIONAL INFORMATION

Lined area for additional information.

If more than one screen, show locations of each on sketch.