

LINCOLN  
A 11

MISSISSIPPI DEPARTMENT OF NATURAL RESOURCES  
Bureau of Land and Water Resources  
Southport Mall  
P.O. Box 10631  
Jackson, Mississippi 39209  
WATER WELL DRILLERS LOG

CODED

11-8-84 19 date well completed      Grenn Water Well firm name      Lincoln county well located

LANDOWNER: Clyde Norton  
Union Church, Ms.      description of formations encountered: Citronelle      from 1 to 58

(mailing address)

WELL LOCATION:  
sec. 21 T 8 N R 5 E  
13 miles NW of Brookhaven (distance) (direction) (nearest town)

CODED

WELL PURPOSE: home  
(home, irrigation, municipal, industrial)

WELL COMPLETION DATA:

- (1) diameter (inches) 4
- (2) total depth (feet) 58
- (3) static water level (feet) 35 below above top of ground.
- (4) casing PVC, 48" (material) (depth)  
4" (size) if telescope see back.
- (5) screen 10' 48' (length) (depth to top)  
010 PVC (size) (material)
- (6) pump did not install (HP) (yield gpm)  
(type power)
- (7) electric log no (yes or no)  
(organization running log)
- (8) how well bottom plugged backwash valve


DRILLERS REMARKS:

RECEIVED  
APR 17 1985

Department of Natural Resources  
Bureau of Land & Water Resources

If well telescopes please sketch and show depths.

GROUND LEVEL

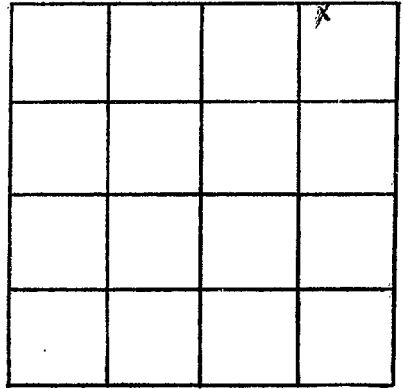

SECTION 21

Please indicate well location X.

ADDITIONAL INFORMATION

If more than one screen,  
show locations of each on sketch.