

MISSISSIPPI DEPARTMENT OF NATURAL RESOURCES
 Bureau of Land and Water Resources
 Southport Mall
 P.O. Box 10631
 Jackson, Mississippi 39209
WATER WELL DRILLERS LOG

CODED

LINCOLN
A 12

6-28 19 86 Grenn Water Well Lincoln
 date well completed firm name county well located

LANDOWNER: Triumph Church
R.t 1, Box 184
Union Church, Ms.
 (mailing address)

description of formations encountered	from	to
Citronelle	1	113

WELL LOCATION:
 sec. 12 T. 8 N. R. 5 E
 S W
13 miles NW of Brookhaven
 (distance) (direction) (nearest town)

WELL PURPOSE: church
 (home, irrigation, municipal, industrial)

WELL COMPLETION DATA:

- (1) diameter (inches) 4
- (2) total depth (feet) 113
- (3) static water level (feet) 76 below top of ground.
- (4) casing PVC 103
 (material) (depth)
4" if telescope see back.
 (size)
- (5) screen 10' 103'
 (length) (depth to top)
.010 PVC
 (size) (material)
- (6) pump 1/2 sub 10
 (HP) (yield gpm)
electricity
 (type power)
- (7) electric log no
 (yes or no)
(organization running log)
- (8) how well bottom plugged back wash valve

CODED


REGISTERED
 JUL 31 1986

Department of Natural Resources
 Bureau of Land & Water
 Bureau of Land & Water

DRILLERS REMARKS:

If well telescopes please sketch and show depths.

GROUND LEVEL

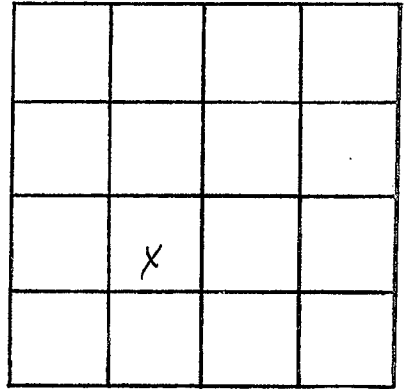

SECTION 12

Please indicate well location X.

ADDITIONAL INFORMATION

If more than one screen,
show locations of each on sketch.