

State Well Report

Part 1

Mississippi Department of Environmental Quality
Office of Land and Water Resources
P.O. Box 10631
Jackson, MS 39289-0631
(601)961-5210
(601)354-6938 (fax)

For Office Use Only

Aquifer: _____
Well #: A30
L. S. Elevation: _____
E-log #: _____

County: Lincoln
Permit #: _____
Driller: GRENN WATER WELL & SUPPLY, INC.
Date drilling completed: 12-19-12

State Law requires that this report be prepared by the driller in detail and filed with the Department within 30 days of completion of drilling of the well.

Well Owner Information	Well Location
Owner Name: <u>Chuck Cannon</u>	Latitude: <u>31° 38' 109"</u> Longitude: <u>90° 39' 159"</u>
Mailing Address: <u>3680 Bowie Mill Rd.</u>	Method of Lat/Long (circle one): <u>Conventional Survey</u>
<u>Brookhaven, Ms. 39601</u>	USGS quad, <u>Hand-held GPS</u> , Survey-grade GPS
City State Zip Code	<u>SE 1/4 NE 1/4</u> Sec <u>25</u> Twn <u>8N</u> Rng <u>7E</u>
Telephone No. <u>(504) 415-7595</u>	Distance Direction Nearest Town <u>6</u> Miles <u>W</u> of <u>Lloyd Star</u>

Well Data

Purpose of Well (circle one) Home Industrial Public Supply Irrigation Fish Culture Other: _____

Date well drilling started: 12-19-12 Date well drilling completed: 12-19-12

If flowing, method of flow regulation: Valve _____ Other (describe) _____

Static Water Level: 146 feet above or below (circle one) land surface Date measured: 12-19-12

Method of Measurement (circle one) steel tape electric tape air line other: _____

Hole depth: 195 Well depth: 193 Well grouted to a depth of 10 feet

Type of grout (circle one): Cement Bentonite Mix

Casing length: 183 feet Casing diameter: 4 inches Type of casing: PVC

Screen length: 10 feet Screen diameter: 4 inches Type of screen: PVC

Screen slot size: 10/10 inches Setting depth: From 183 feet to 193 feet

Type of completion (circle all applicable): Gravel packed Underreamed Telescoped Open hole Natural Development

Other (describe): _____

Top of lap pipe or reduction in casing: _____ feet. If telescoped or more than one screen, describe on back of page

Logs run (circle all applicable): No log run Electric Gamma Ray Density Sonic Neutron Other: _____

Name of organization running log(s): _____

I certify that the well was drilled, constructed, and completed in accordance with all applicable requirements of the Mississippi Department of Environmental Quality and/or the Mississippi Department of Health regulations and state laws.

GRENN WATER WELL & SUPPLY, INC.
Brian McClendon, lic. no. 0-664

Print Name of Water Well Contractor and License No. Brian McClendon
Signature of Water Well Contractor

RECEIVED
JAN 03 2013
BY: OLWR


A 30

If well telescopes please sketch below and show depths.

Ground Level

Description of Formations Encountered	From	To
red clay	0	17
sand & gravel	17	76
white clay	76	93
blue clay	93	107
white clay	107	130
sand	130	148

If more than one screen, show location of each on sketch

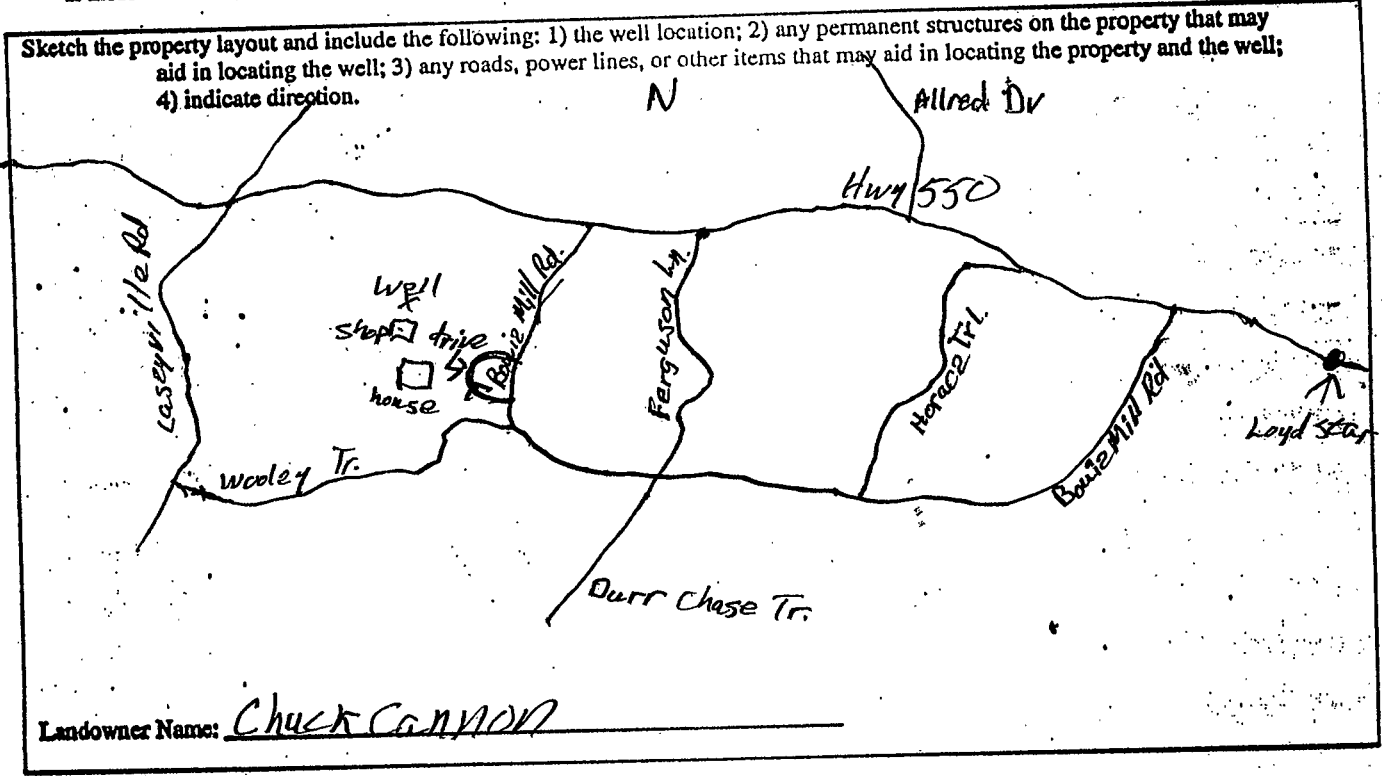

Brian McClendon, lic. no. 0-664
 GRENN WATER WELL & SUPPLY, INC.

Brian McClendon
 Signature of Water Well Contractor