

Lincoln
 A 2000
 11-13-75

MISSISSIPPI
 BOARD OF WATER COMMISSIONERS
 416 North State Street
 Jackson, Mississippi 39201

WATER WELL DRILLERS LOG

Nov. 13 1975 Remer Well Service Lincoln
 date well completed firm name county well located

LANDOWNER:
Mr. Parathugh Henderson
Rt. 2 Birmingham
 (mailing address)

description of formations encountered	from	to
Red Clay	0	20
sand & gravel	20	80
white chalk	80	122
coarse sand	122	150

WELL LOCATION:
 sec. 9 T. 9 N. R. 5 E
3 1/2 miles West of Cossville
 (distance) (direction) (nearest town)

WELL PURPOSE: home
 (home, irrigation, municipal, industrial)

- WELL COMPLETION DATA:
- (1) diameter (inches) 4"
 - (2) total depth (feet) 150
 - (3) static water level (feet) 118 below top of ground.
 - (4) casing plastic bottom
 (material) (depth)
 - If telescope see back.
 (size)
 - (5) screen 6" 112
 (length) (depth to top)
 - 4" plastic
 (size) (material)
 - (6) pump 1/2 Sub 10
 (HP) (yield gpm)
 - elect
 (type power)
 - (7) electric log No
 (yes or no)
 - (organization running log)


(8) how well bottom plugged
Wagon plug

DRILLERS REMARKS:
new house

RECORDED
 JAN 12 1976
 BOARD OF WATER COMMISSIONERS

If well telescopes please sketch and show depths.

GROUND LEVEL

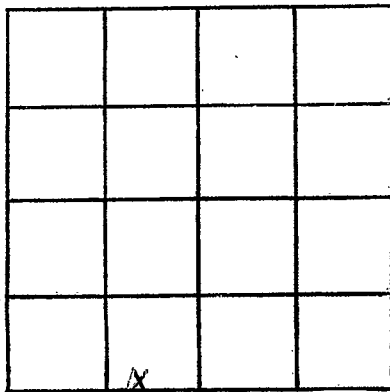

SECTION 9

Please indicate well location X.

ADDITIONAL INFORMATION

If more than one screen,
show locations of each on sketch.