

Lincoln
A 2002
8-15-79

MISSISSIPPI
BOARD OF WATER COMMISSIONERS
416 North State Street
Jackson, Mississippi 39201

WATER WELL DRILLERS LOG

Aug 15 19 79 Reems Miller Lincoln
date well completed firm name county well located

LANDOWNER:
Reems Kimble
Rt. Brookhaver
(mailing address)

WELL LOCATION:
sec 25 T 8 N R 5 E
14 miles W of Brindley
(distance) (direction) (nearest town)

WELL PURPOSE: house
(home, irrigation, municipal, industrial)

WELL COMPLETION DATA:

(1) diameter (inches) 4"

(2) total depth (feet) 240'

(3) static water level (feet) 153 below top of ground.

(4) casing plastic (material) bottom (depth)

If telescope see back. (size)

(5) screen 10' (length) 230' (depth to top)

4" (size) plastic (material)

(6) pump 1 hp (HP) 15 (yield gpm)

elect (type power)

(7) electric log no (yes or no)

(organization running log)

description of formations encountered	from	to
Clay	0	17
Gravel	17	25
Sand	25	60
sand Rock	60	62
blue Chalk	62	120
fine sand	120	218
Coarse sand	218	240

DEPT. OF NATURAL RESOURCES
BUREAU OF LAND & WATER RESOURCES

MAY 20 1980


RECEIVED

(8) how well bottom plugged
wooden plug

DRILLERS REMARKS:
[Signature]

If well telescopes please sketch and show depths.

GROUND LEVEL

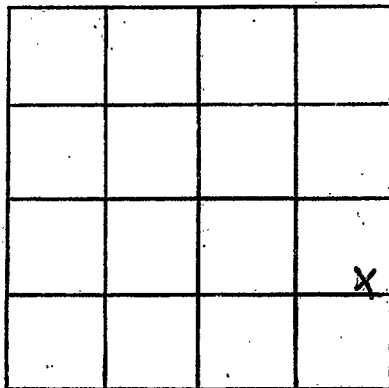

SECTION 25

Please indicate well location X.

ADDITIONAL INFORMATION

If more than one screen, show locations of each on sketch.