

Lincoln
 A 2003
 July 5, 1977

MISSISSIPPI
 BOARD OF WATER COMMISSIONERS
 416 North State Street
 14A Jackson, Mississippi 39201

WATER WELL DRILLERS LOG

July 5 1977 Grenn Water Well Cont. Lincoln
 date well completed firm name county well located

LANDOWNER: H.L. Craddock 5407 Hebron	description of fomations encountered citronelle	from 1	to 64
Memphis, Tenn. 38116 (mailing address)			
WELL LOCATION:			
sec. 28 T 8 N R 5 E S W			
13 miles NW of Brookhaven (distance) (direction) (nearest town)			
WELL PURPOSE: home (home, irrigation, municipal, industrial)			
WELL COMPLETION DATA:			
(1) diameter (inches) 6			
(2) total depth (feet) 64			
(3) static water level (feet) 40 below top of ground.			
(4) casing PVC 52 (material) (depth) 4" (size) if telescope see back.			
(5) screen 12' 52' (length) (depth to top) .010 PVC (size) (material)			
(6) pump 1/2 HP sub 10 (HP) (yield gpm) electricity (type power)			
(7) electric log no (yes or no) (organization running log)			
(8) how well bottom plugged back wash valve			
DRILLERS REMARKS:			


RECEIVED

AUG 24 1977

MISS. BD. OF WATER COMMISSIONERS

If well telescopes please sketch and show depths.

GROUND LEVEL

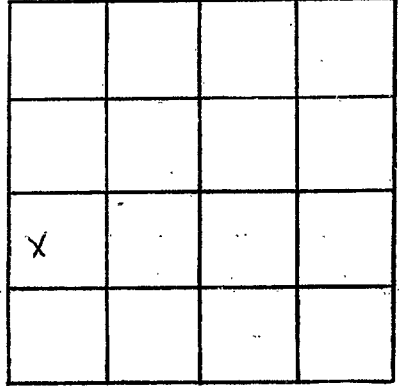

SECTION 28

Please indicate well location X.

ADDITIONAL INFORMATION

If more than one screen, show locations of each on sketch.