

LINCOLN

A 2004

02-16-79

MISSISSIPPI
BOARD OF WATER COMMISSIONERS
416 North State Street
Jackson, Mississippi 39201

WATER WELL DRILLERS LOG

Feb. 16 19 79 Grenn Water Well Cont. Lincoln
date well completed firm name county well located

LANDOWNER:	description of formations encountered	from	to
Francis Case Route 1, Box 171 Union Church, Ms. 39668 (mailing address)	Citronelle	1	132
WELL LOCATION:			
sec. 28 T. 8 N R. 5 E S W 13 miles NW Brookhaven (distance) (direction) of (nearest town)			
WELL PURPOSE: home (home, irrigation, municipal, industrial)			
WELL COMPLETION DATA:			
(1) diameter (inches) 4			
(2) total depth (feet) 132			
(3) static water level (feet) 90 below top of ground. above			
(4) casing PVC 120 (material) (depth) 4" (size) if telescope see back.			
(5) screen 12' 120' (length) (depth to top) .010 PVC (size) (material)			
(6) pump did not install (HP) (yield gpm) (type power)			
(7) electric log no (yes or no) (organization running log)			
(8) how well bottom plugged backwash valve			
DRILLERS REMARKS:			


Miss. Board of Water Comm.

MAY 9 1979

RECEIVED

If well telescopes please sketch and show depths.

GROUND LEVEL

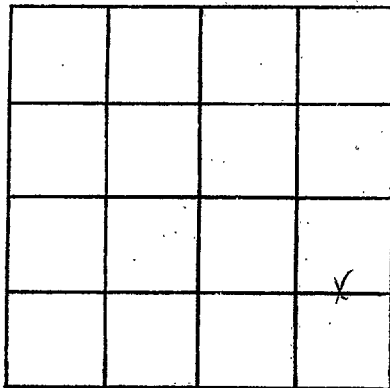

SECTION 28

Please indicate well location X.

ADDITIONAL INFORMATION

If more than one screen,
show locations of each on sketch.