

MISSISSIPPI DEPARTMENT OF NATURAL RESOURCES

Bureau of Land and Water Resources

Southport Mall

P.O. Box 10631

Jackson, Mississippi 39209

WATER WELL DRILLERS LOG

Lincoln  
A  
2006

1-6 1984 F. J. Wallwell, Inc. firm name Lincoln county well located


LANDOWNER:	description of formations encountered	from	to
<u>Willard Seals</u>	<u>Red clay</u>	<u>0</u>	<u>20</u>
<u>R.R. Smithdale, Mrs.</u> (mailing address)	<u>Red sand</u>	<u>20</u>	<u>60</u>
<b>WELL LOCATION:</b> sec. <u>17</u> T <u>S</u> N R. <u>10</u> E W	<u>white + blue clay</u>	<u>60</u>	<u>205</u>
<u>8</u> miles <u>WNW</u> of <u>AUBURN</u> (distance) (direction) (nearest town)	<u>Coarse sand &amp; gravel</u>	<u>205</u>	<u>220</u>
<b>WELL PURPOSE:</b> (home, irrigation, municipal, industrial) <u>Home</u>			
<b>WELL COMPLETION DATA:</b>			
(1) diameter (inches) <u>4</u>			
(2) total depth (feet) <u>230</u>			
(3) static water level (feet) <u>130</u> below above top of ground.			
(4) casing <u>PVC</u> , <u>212</u> (material) (depth)			
<u>4</u> (size) if telescope see back.			
(5) screen <u>8</u> , <u>212</u> (length) (depth to top)			
<u>4</u> , <u>PVC</u> (size) (material)			
(6) pump <u>3/4</u> , <u>12</u> (HP) (yield gpm)			
<u>Plus</u> (type power)			
(7) electric log <u>No</u> (yes or no)			
(organization running log)			
(8) how well bottom plugged <u>Seal block</u>			
<b>DRILLERS REMARKS:</b>			

DEPT. OF NATURAL RESOURCES  
 BUREAU OF LAND & WATER RESOURCES

MAR - 8 1984  
 RECEIVED

If well telescopes please  
sketch and show depths.

GROUND LEVEL

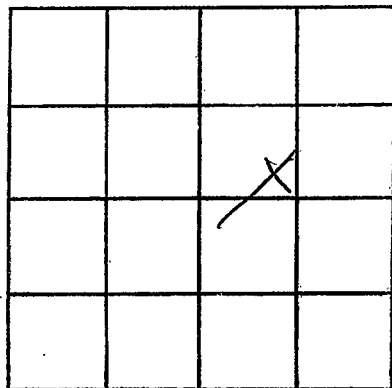

SECTION 17

Please indicate well location X.

ADDITIONAL INFORMATION

If more than one screen,  
show locations of each on sketch.