

MISSISSIPPI DEPARTMENT OF ENVIRONMENTAL QUALITY
Office of Land and Water Resources

P. O. Box 10631
Jackson, MS 39289-0631
WATER WELL DRILLERS LOG

COUNTY WELL LOCATED Lincoln	
WELL NUMBER A 2018	CODED
DATE WELL COMPLETED 4/13/01	

PERMIT NUMBER Green Water Well & Supply
NAME OF CONTRACTOR Boyle Chitto, MS 39020

NAME & MAILING ADDRESS OF LANDOWNER M. G. Magee			
2668 Hwy 550 NW			
Wesson			
WELL LOCATION:	SEC 2	TOWNSHIP 8	RANGE 5
		(N) (S)	(E) (W)
DISTANCE 2 Miles	DIRECTION NW	NEAREST TOWN Caseyville	
OTHER LANDMARK			
WELL PURPOSE: <input checked="" type="checkbox"/> Home, <input type="checkbox"/> Irrigation, <input type="checkbox"/> Municipal, <input type="checkbox"/> Industrial, <input type="checkbox"/> Fish Pond, etc.			

PUMP DATA		
PUMP TYPE (Circle One): <input checked="" type="checkbox"/> Submersible, <input type="checkbox"/> Turbine, <input type="checkbox"/> Jet, <input type="checkbox"/> Flowing Well, Other (Describe) _____		
POWER TYPE (Circle One): <input checked="" type="checkbox"/> Electric, <input type="checkbox"/> Tractor, <input type="checkbox"/> Diesel, <input type="checkbox"/> Gasoline, <input type="checkbox"/> Butane, Other (Describe) _____ H/P 1/2		
Pump Capacity (GPM) 10	No. of Stages 9	Setting Depth 99 FT.
PUMP TEST		
Well yielded 7 GPM with a drawdown of 40 ft. after 30 min. hours of pumping		

WELL DATA		
Well Depth 100	Casing Diameter (In.) 4"	Casing Length (Ft.) 80
Type of Casing PVC	Hole Depth 340'	Depth to Static Water Level 58

LOG DATA	
TYPE OF LOG RUN (Circle One): <input checked="" type="checkbox"/> No Log Run, Electric, Gamma Ray, Density, Sonic, Neutron, Other (Describe) _____	
Name of Organization Running Log	

TYPE OF COMPLETION: (Circle One or More):
 Gravel Packed, Underreamed, Telescoped,
 Natural Development, Open Hole, Other
(Describe) _____

GEOLOGIC DATA (Office Use Only)			
Surface Elev.	Geologic Unit	Unit Thickness	Depth to Top
Subs. SWL	Date	Analysis	Aquifer Test

WELL GROUTED TO A DEPTH OF **10** FEET
Type Grout (circle one): Cement, Bentonite, or Mix

SCREEN DATA		
Diameter - Inches 4	Length - Feet 20	Slot Size - Inches .010
Screen Type PVC	Depth to Bottom - Feet 80 80	

Driller's Remarks
Top of Lap Pipe or Reduction in Casing
FEET
IF TELESCOPED OR MORE THAN ONE SCREEN: USE BACK PAGE


DESCRIPTION OF FORMATIONS ENCOUNTERED	FROM	TO
Red Clay	0	12
Sand	12	80
White Clay	80	92
Streaky	92	107
Blue Clay	107	340

FORMATIONS (Continued)	FROM	TO
REC'D JUN 13 2001		

IF MORE SPACE IS NEEDED, USE BACK

If well telescopes please sketch and show depths.

GROUND LEVEL

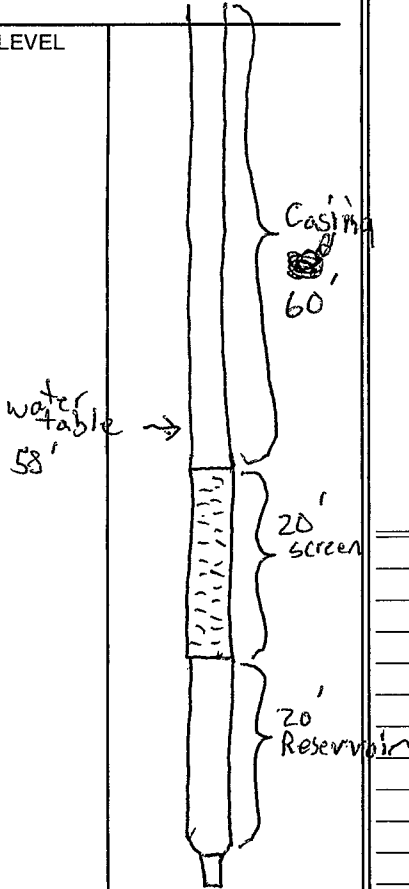

	X		

SECTION 2

Please indicate well location X.

ADDITIONAL INFORMATION

If more than one screen,
show location of each on sketch.