

B1

CODED

11-15-60

WATER WELL DRILLERS LOG

Date: 11/15, 1960, Driller: E.B. Fore J, County: Lincoln

(Name)

(1) Owner of Land: Vernon R. Cade
 (Name)
Rt 1 Wesson, Miss
 (Address)
 (2) Location: SW 1/4, SW 24 8 6
 1/4, Sec. 1, R. 6
1 1/2 miles N. of Stat.
 (distance) (direction) (Nearest Town)
 (3) Topography: Hilly
 (Hilly) (Flat) (Level)
 (4) Purpose of Well: Domestic
 (Domestic Irrigation
 Municipal, Industrial, Other)

Description & Color of Materials Sand, Clay, Red Clay, Shell, etc.	Thick- ness Feet	Depth Feet
Brown Clay	0	10
Brown Sand, Cl.	10	20
Brown Sand	20	30
Soft Clay + Sand	30	40
" " " "	40	50
Sand + gravel	50	60
" " " "	60	68
White Clay	68	85
Sand -	85	125


Information upon completion of well:

(1) Diameter 6 1/2 inches.
 (2) Total Depth 125 feet.
 (3) Water Level _____ feet below top of ground.
 (4) Cased to 125', Size 4"
 (5) Screen: Size _____, Length _____
 (6) Were any formations sealed against pollution?
 _____ yes, no.

CODED

If YES depth of formation _____
Why _____

Drillers Remarks: _____

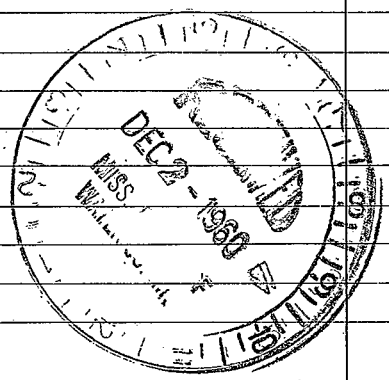

(Use Back Side)

[The page contains extremely faint and illegible text, likely bleed-through from the reverse side of the document. The text is scattered across the page and cannot be transcribed.]