

LINCOLN

MISSISSIPPI BOARD OF WATER COMMISSIONERS

B2

CODED

~~B-301~~

11-9-60

WATER WELL DRILLERS LOG

Date: Nov. 9, 1960, Driller: E. B. Foreg County: Lincoln
(Name)

(1) Owner of Land:	Description & Color of Materials Sand, Clay, Red Clay, Shell, etc.	Thick- ness Feet	Depth Feet
<u>William L. Applewhite</u> (Name) <u>Rt. 1 Box 102 Wesson Miss</u> (Address)	<u>0-10 Br. Cl.</u>	<u>0</u>	<u>10</u>
(2) Location: <u>SE 1/4, NW 1/4, Sec. 9 & R. 6</u> <u>14 miles N.W Brookhaven</u> (distance) (direction) (Nearest Town)	<u>10-20 Red Cl</u> <u>Red Sdy. Cl.</u>	<u>10</u> <u>20</u>	<u>20</u> <u>30</u>
(3) Topography: <u>Hilly</u> (Hilly) (Flat) (Level)	<u>Gravel</u>	<u>35</u>	<u>60</u>
(4) Purpose of Well: <u>Domestic</u> (Domestic Irrigation Municipal, Industrial, Other)	<u>Sand + Gravel</u>	<u>60</u>	<u>90</u>
	<u>Clay with gravel</u> <u>shales</u>	<u>90</u>	<u>110</u>

Information upon completion of well:


- (1) Diameter 6 1/2 inches.
- (2) Total Depth 145 feet.
- (3) Water Level 100 feet below top of ground.
- (4) Cased to 145, Size 4"
- (5) Screen: Size _____, Length _____
- (6) Were any formations sealed against pollution?
_____ yes, No no.

If YES depth of formation _____

Why _____

Drillers Remarks: _____

CODED

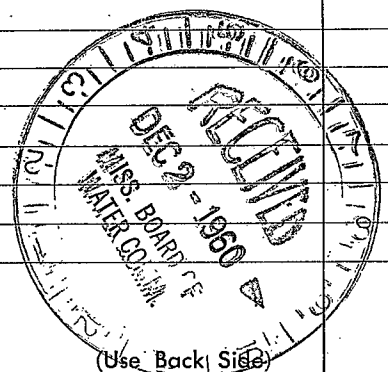

Well No.

1870

1871
 1872
1870
 1871
 1872
1870