

LINCOLN CODED WATER WELL DRILLERS LOG

B3

Date: 7-15, 1961, Driller: *A. H. ...* County *Pike*
 7-15-61 (Name)

(1) Owner of Land: *Burice Case*
 (Name)
Rt 1 Messon
 (Address)

(2) Location: *N 1/4 N 1/4 Sec. 16 T 8 R 6*
12 miles *W* of *Brookman*
 (distance) (direction) (Nearest Town)

(3) Topography: *Level*
 (Hilly) (Flat) (Level)

(4) Purpose of Well: *Domestic*
 (Domestic Irrigation
 Municipal, Industrial, Other)

Description & Color of Materials Sand, Clay, Red Clay, Shell, etc.	Thick- ness Feet	Depth Feet
<i>Top soil & clay</i>	<i>0</i>	<i>20</i>
<i>Red Sand</i>	<i>20</i>	<i>45</i>
<i>Red Sand & gravel</i>	<i>45</i>	<i>68</i>
<i>Fine Sand</i>	<i>25</i>	<i>95</i>
<i>White (Chalk)</i>	<i>75</i>	<i>100</i>
<i>Fine Sand</i>	<i>100</i>	<i>120</i>
<i>Coarse Sand & Gravel</i>	<i>20</i>	<i>135</i>

Information upon completion of well:

(1) Diameter *4* inches.

(2) Total Depth *131* feet.

(3) Water Level *70* feet below top of ground.

(4) Cased to *125*, Size *4*


(5) Screen: Size *2*, Length *5*

(6) Were any formations sealed against pollution?
 _____ yes, _____ no.

CODED

If YES depth of formation _____
 Why _____

Drillers Remarks: _____

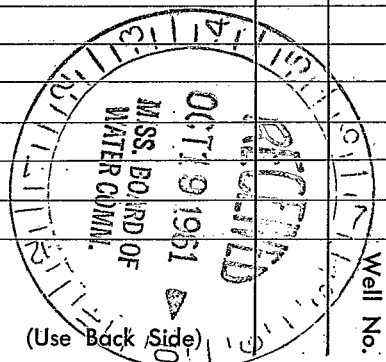

Well No. _____

(Use Back Side)

