

# WATER WELL DRILLERS LOG

**LINCOLN**

Date: 9-2, 1961, Driller: W. H. Mossey County: Pike

**B4 CODED**

(Name)

(1) Owner of Land: Robt L. Smith  
(Name)

Brookhaven Miss  
(Address)

(2) Location: NE 1/4, NW 1/4, Sec. 18 T. 8 R. 6  
(Address)

15 miles West of Brookhaven  
(distance) (direction) (Nearest Town)

(3) Topography:  (Hilly)  (Flat)  (Level)

(4) Purpose of Well: Domestic  
(Domestic Irrigation, Municipal, Industrial, Other)

Description & Color of Materials Sand, Clay, Red Clay, Shell, etc.	Thick- ness Feet	Depth Feet
<del>0-25</del> <u>Topsoil &amp; clay</u>		<u>0-25</u>
<u>sand &amp; gravel</u>	<u>25-125</u>	
<u>fine sand &amp; some shells</u>	<u>125-140</u>	
<u>sand &amp; gravel</u>	<u>140-156</u>	

**Information upon completion of well:**

(1) Diameter 4 inches.

(2) Total Depth 156 feet.

(3) Water Level 120 feet below top of ground.

(4) Cased to 150, Size 4

(5) Screen: Size 2, Length 6"


(6) Were any formations sealed against pollution?  
\_\_\_\_\_ yes,  no.

If YES depth of formation \_\_\_\_\_

Why \_\_\_\_\_

Drillers Remarks: \_\_\_\_\_

CODED

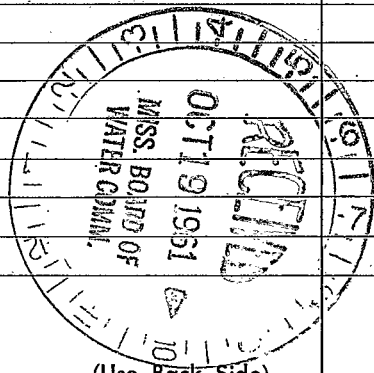

(Use Back Side)

Well No.

