

**MISSISSIPPI  
BOARD OF WATER COMMISSIONERS**  
416 North State Street  
Jackson, Mississippi 39201

**WATER WELL DRILLERS LOG**

Lincoln  
B5 CODED  
3-67

3-7 1967 *Fitzgerald Water Well Service* Lincoln  
date well completed firm name county well located

LANDOWNER: *Thomas Smith*  
*Rt 1 Mossom Miss 39103*

(mailing address)

**WELL LOCATION:**

sec. 10 T. 8 N. R. 6 E  
12 miles NW of Brookfield  
(distance) (direction) (nearest town)


WELL PURPOSE: home  
(home, irrigation, municipal, industrial)

**WELL COMPLETION DATA:**

- (1) diameter (inches) 4
- (2) total depth (feet) 178
- (3) static water level (feet) 8.5 below above top of ground.
- (4) casing plastic 172  
(material) (depth)  
4 if telescope see back.  
(size)
- (5) screen 6 172  
(length) (depth to top)  
2 plastic  
(size) (material)
- (6) pump 1 8  
(HP) (yield gpm)  
elec  
(type power)
- (7) electric log NO  
(yes or no)  
Wood Peg  
(organization running log)
- (8) how well bottom plugged Wood Peg

description of formations encountered	from	to
<i>top soil Red Clay</i>	<i>0</i>	<i>5</i>
<i>hardpan</i>	<i>20</i>	<i>55</i>
<i>Chalk</i>	<i>55</i>	<i>65</i>
<i>Heavy sand</i>	<i>65</i>	<i>85</i>
<i>fine sand</i>	<i>85</i>	<i>99</i>
<i>soft red clay</i>	<i>99</i>	<i>100</i>
<i>White Chalk</i>	<i>100</i>	<i>131</i>
<i>Coarse sand</i>	<i>135</i>	<i>180</i>


CODED

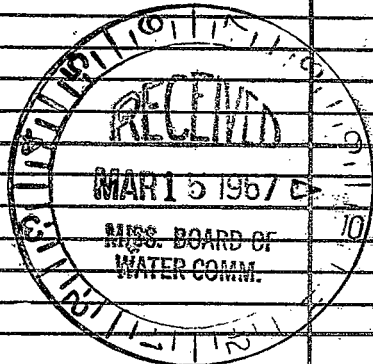

DRILLERS REMARKS:

If well telescopes please sketch and show depths.

GROUND LEVEL

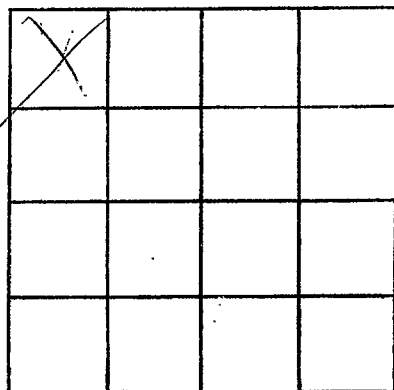

SECTION 10

Please indicate well location X.

ADDITIONAL INFORMATION

If more than one screen, show locations of each on sketch.