

Lirical
 B6
 6-67 CODED

MISSISSIPPI
 BOARD OF WATER COMMISSIONERS
 416 North State Street
 Jackson, Mississippi 39201

WATER WELL DRILLERS LOG

June 14, 1967 Fitzgerald W. K. Sarcee Lincoln
 date well completed firm name county well located

LANDOWNER: Billy H Justice
Rt 1 Wesson Miss

description of formations encountered	from	to
top soil / Red clay	0	15
Red sand	15	35
Gravel	35	63
Chalk	63	85
Gravel sand	85	98
sand	98	115
Brackish sand & p. gravel	115	132

(mailing address)

WELL LOCATION:
 sec 28 T 8 N 6 E
10 miles W of Brackburn
 (distance) (direction) (nearest town)

WELL PURPOSE: Home
 (home, irrigation, municipal, industrial)

WELL COMPLETION DATA:

- (1) diameter (inches) 4
- (2) total depth (feet) 132
- (3) static water level (feet) 80 below above top of ground.
- (4) casing plastic 1 1/4
 (material) (depth)
4 if telescope see back.
 (size)
- (5) screen 6 1 1/4
 (length) (depth to top)
4 plastic
 (size) (material)
- (6) pump 1/2 sub 12
 (HP) (yield gpm)
elec
 (type power)
- (7) electric log NO
 (yes or no)
 (organization running log)
- (8) how well bottom plugged Wad peg


CODED



DRILLERS REMARKS:

If well telescopes please sketch and show depths.

GROUND LEVEL

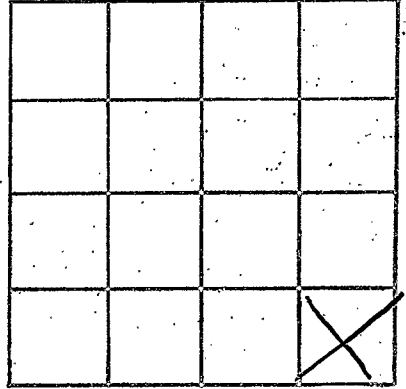

SECTION

28

Please indicate well location X.

ADDITIONAL INFORMATION

If more than one screen,
show locations of each on sketch.