

Lincoln
 B B7
 9-67 CODED

MISSISSIPPI
 BOARD OF WATER COMMISSIONERS
 416 North State Street
 Jackson, Mississippi 39201

WATER WELL DRILLERS LOG

9-12 1967 Fitzgerald Water Well Service, Lincoln
 date well completed firm name county well located

LANDOWNER: Hulon Smith
RT 1, Yesson, Miss
 (mailing address)

WELL LOCATION:
 sec. 9 T 8 N R 6 E
14 miles NW of Brickhaven
 (distance) (direction) (nearest town)

WELL PURPOSE: home
 (home, irrigation, municipal, industrial)

WELL COMPLETION DATA:

(1) diameter (inches) 4

(2) total depth (feet) 197

(3) static water level (feet) 90 below/above top of ground.

(4) casing plastic 186
 (material) (depth)
 (size) if telescope see back.

(5) screen 6" 186
 (length) (depth to top)
4 plastic
 (size) (material)

(6) pump 1 Jet B
 (HP) (yield gpm)
Elec
 (type power)

(7) electric log no
 (yes or no)
 (organization running log)

(8) how well bottom plugged wood peg


description of formations encountered	from	to
top soil & clay	0	20
Red chalk	20	60
gravel & sand	60	67
Rock	67	69
White Chalk	69	69
Coarse sand	69	69
Chalk	197	



DRILLERS REMARKS:

If well telescopes please sketch and show depths.

GROUND LEVEL

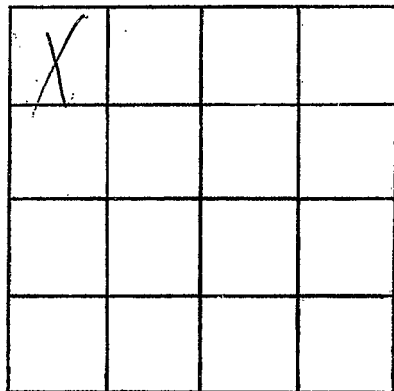

SECTION 7

Please indicate well location X.

ADDITIONAL INFORMATION

If more than one screen, show locations of each on sketch.