

**MISSISSIPPI
BOARD OF WATER COMMISSIONERS**
416 North State Street
Jackson, Mississippi 39201

WATER WELL DRILLERS LOG

Lincoln
B8
9-67 CODED

9-27 19*67* *Alperald Water Well* *Lincoln*
date well completed firm name county well located

LANDOWNER: *Elon White*
Wesson Rt, Miss

description of formations encountered	from	to
<i>Top soil & clay</i>	<i>0</i>	<i>24</i>
<i>sand</i>	<i>24</i>	<i>42</i>
<i>sand & gravel</i>	<i>42</i>	<i>80</i>
<i>chalk Red</i>	<i>80</i>	<i>98</i>
<i>sand & gravel</i>	<i>98</i>	<i>110</i>
<i>sand</i>	<i>110</i>	<i>115</i>
<i>sand & gravel</i>	<i>115</i>	<i>130</i>
<i>Blind</i>	<i>130</i>	

(mailing address)

WELL LOCATION:
sec. *11* T *8* N R *6* E
S W
14 miles *W-NW* of *Brook Haven*
(distance) (direction) (nearest town)


WELL PURPOSE: *home*
(home, irrigation, municipal, industrial)

WELL COMPLETION DATA:

- (1) diameter (inches) *4*
- (2) total depth (feet) *130*
- (3) static water level (feet) *115* below/above top of ground.
- (4) casing *plastic 124*
(material) (depth)
4 If telescope see back.
(size)
- (5) screen *61 124*
(length) (depth to top)
4 plastic
(size) (material)
- (6) pump *Spec*
(HP) (yield gpm)
(type power)
- (7) electric log *NO*
(yes or no)
(organization running log)
- (8) how well bottom plugged *Wood peg*

CODED

DRILLERS REMARKS:

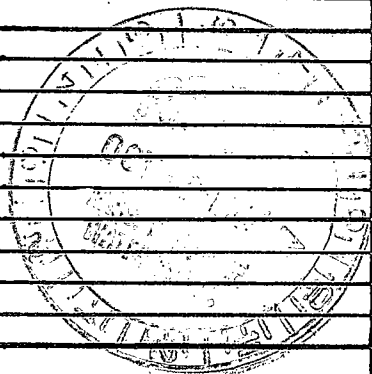

If well telescopes please sketch and show depths.

GROUND LEVEL

X			

SECTION *17*

Please indicate well location X.

ADDITIONAL INFORMATION

If more than one screen,
show locations of each on sketch.