

Lincoln
B9
9-67

MISSISSIPPI
BOARD OF WATER COMMISSIONERS
416 North State Street
Jackson, Mississippi 39201

WATER WELL DRILLERS LOG

9-26 1967 Hesperal Water Well Lincoln
date well completed firm name county well located

LANDOWNER: W.D. Paxton
Brookhaven RA Miss
(mailing address)

WELL LOCATION:
sec 33 T 8 N R 6 E
S W
10 miles W of Brookhaven
(distance) (direction) (nearest town)

WELL PURPOSE: house
(home, irrigation, municipal, industrial)

WELL COMPLETION DATA:

(1) diameter (inches) 4

(2) total depth (feet) 280

(3) static water level (feet) 130 below above top of ground.

(4) casing plastic 274
(material) (depth)

4 If telescope see back.
(size)

(5) screen 6" 274
(length) (depth to top)

4" plastic
(size) (material)

(6) pump 3/12
(HP) (yield gpm)

2hp
(type power)

(7) electric log Me
(yes or no)

(organization running log)
Wood peg


(8) how well bottom plugged

DRILLERS REMARKS:

description of formations encountered	from	to
<u>top soil/clay</u>	<u>0</u>	<u>18</u>
<u>sand & gravel</u>	<u>18</u>	<u>68</u>
<u>white chalk</u>	<u>68</u>	<u>76</u>
<u>sand fine</u>	<u>76</u>	<u>102</u>
<u>white chalk</u>	<u>102</u>	<u>122</u>
<u>Rock</u>	<u>122</u>	<u>125</u>
<u>white chalk, white blue etc</u>	<u>125</u>	<u>196</u>
<u>pink sand</u>	<u>196</u>	<u>248</u>
<u>crayset sand</u>	<u>248</u>	<u>280</u>


CODED

WHITE CHALK

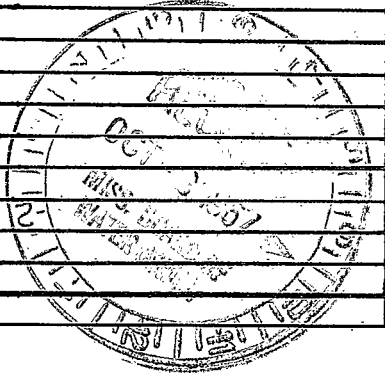

If well telescopes please sketch and show depths.

GROUND LEVEL

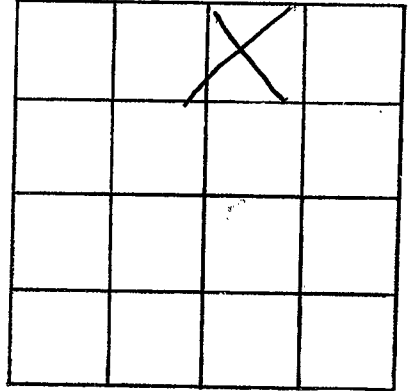

SECTION 33

Please indicate well location X.

ADDITIONAL INFORMATION

If more than one screen, show locations of each on sketch.