

Lincoln
 B11
 9-67

MISSISSIPPI
 BOARD OF WATER COMMISSIONERS
 416 North State Street
 Jackson, Mississippi 39201

WATER WELL DRILLERS LOG

9-28-1967 date well completed
 1967 Fitzgerald Water Well firm name
 Lincoln county well located

LANDOWNER: Mrs E E McRae
 Wesson Rt 1 Miss
 (Caseyville)
 (mailing address)

description of formations encountered	from	to
Top soil & clay	0	12
Sand & gravel	12	37
Sand	37	55
Sand & gravel	55	80
Red chert	80	98
Fine sand	98	132
Impure gravel sand	132	140

WELL LOCATION:
 sec. 17 T 8 N R 6 E
 S W
 14 miles (distance) W (direction) Brookhaven (nearest town)

WELL PURPOSE: house
 (home, irrigation, municipal, industrial)

WELL COMPLETION DATA:

(1) diameter (inches) 4

(2) total depth (feet) 140

(3) static water level (feet) 90 below top of ground.

(4) casing plastic 134 (material) (depth)

4 (size) If telescope see back.

(5) screen 6" 134 (length) (depth to top)

4 plastic (size) (material)

(6) pump (HP) (yield gpm)


Dec (type power)

(7) electric log No (yes or no)

(organization running log)

(8) how well bottom plugged Wood peg


CODED

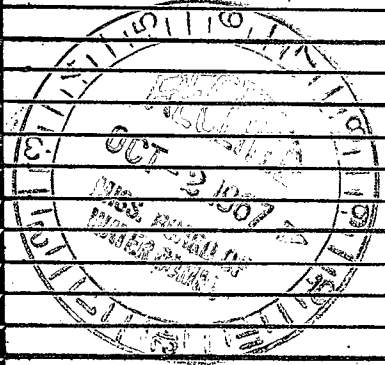

DRILLERS REMARKS:

If well telescopes please sketch and show depths.

GROUND LEVEL

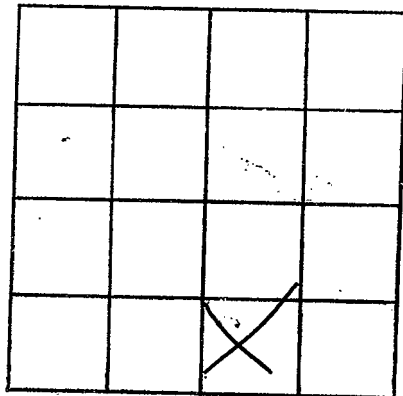

SECTION 17

Please indicate well location X.

ADDITIONAL INFORMATION

If more than one screen,
show locations of each on sketch.