

MISSISSIPPI
BOARD OF WATER COMMISSIONERS
416 North State Street
Jackson, Mississippi 39201

WATER WELL DRILLERS LOG

Lincoln
B12
1-68 CODED

1-27
date well completed

1968 *Fitzgerald Water Well Lincoln*
firm name county well located

LANDOWNER: *David W. Bata*
Wesson Rd MISS
(mailing address)

description of formations encountered	from	to
<i>Top soil & clay</i>	<i>0</i>	<i>14</i>
<i>Sand</i>	<i>14</i>	<i>38</i>
<i>Gravel</i>	<i>38</i>	<i>25</i>
<i>Red Chalk</i>	<i>25</i>	<i>85</i>
<i>Fine Sand</i>	<i>85</i>	<i>22</i>
<i>Medium Sand</i>	<i>22</i>	<i>133</i>
<i>Coarse Sand</i>	<i>133</i>	<i>142</i>


WELL LOCATION:
sec *18* T *8* N *6* E
12 miles *NW* of *Brookhaven*
(distance) (direction) (nearest town)

WELL PURPOSE:
(home, irrigation, municipal, industrial)

- WELL COMPLETION DATA:
- (1) diameter (inches) *4*
 - (2) total depth (feet) *142*
 - (3) static water level (feet) *100* below above top of ground.
 - (4) casing *Plastic* (material) *136* (depth)
4 (size) if telescope see back.
 - (5) screen *6'* (length) *136* (depth to top)
4 (size) *Sch 40* (material)
 - (6) pump (HP) (yield gpm)
Elec (type power)
 - (7) electric log *NO* (yes or no)
(organization/running log)
 - (8) how well bottom plugged *David Pegg*


CODED

DRILLERS REMARKS:

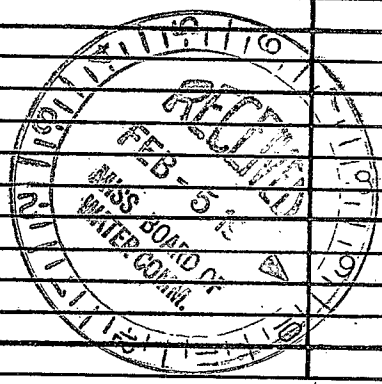

If well telescopes please
sketch and show depths.

GROUND LEVEL

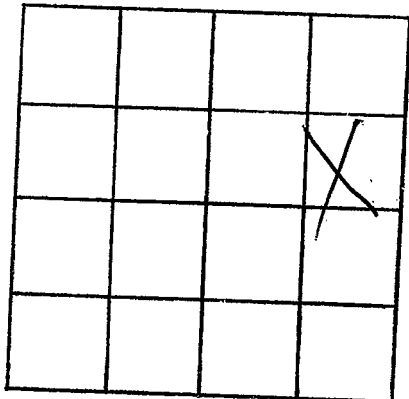

SECTION 18

Please indicate well location X.

ADDITIONAL INFORMATION

If more than one screen,
show locations of each on sketch.