

B 13

CODED

10269

WATER WELL DRILLERS LOG

CODED

10-19-62

Date: 10-19, 1962, Driller: Chester Lewis Lincoln County

286 (Name)

(1) Owner of Land: Nathan Brewer  
 (Name)  
 RFD-1, Wesson  
 (Address)  
 4 miles north of  
 (Location) 1/4, 1/4, Sec. 12  
 11 miles West of Brookhaven  
 (distance) (direction) (Nearest Town)  
 (3) Topography: Hilly  
 (Hilly) (Flat) (Level)  
 (4) Purpose of Well: Domestic  
 (Domestic Irrigation Municipal, Industrial, Other)


Description & Color of Materials Sand, Clay, Red Clay, Shell, etc.	Thick- ness Feet	Depth Feet
Red Clay & Sand	89	89
sand	5	94
blue chalk	27	121
Coarse sand	10	131

CODED

CODED

Information upon completion of well:

(1) Diameter 4 inches.  
 (2) Total Depth 131 feet.  
 (3) Water Level 82 feet below top of ground.  
 (4) Cased to Bottom, Size 4"  
 (5) Screen: Size 4", Length 4"  
 (6) Were any formations sealed against pollution?  
 yes, no.

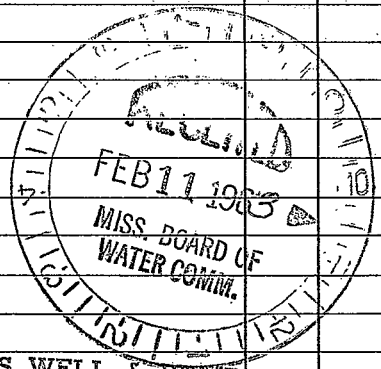

REEVES WELL & PUMP CO.  
 P. O. BOX 71 - PHONE 684-1451  
 McCOMB, MISS.

If YES depth of formation  
 Why  
 Drillers Remarks: Bad well

Well No.

(Use Back Side)

