

C

Lincoln
B 14 CODED
4-68

MISSISSIPPI
BOARD OF WATER COMMISSIONERS
416 North State Street
Jackson, Mississippi 39201

WATER WELL DRILLERS LOG

4-27 1968 Fitzgerald well in Lincoln
date well completed Dr name county well located

LANDOWNER: Robert Earl Smith
RR. Caseyville Miss
(mailing address)

description of formations encountered	from	to
Red clay	0	20
Red gravel	20	80
Red sand	80	120
Coarse sand & gravel	120	130
Fine white sand	130	206
Coarse sand	206	217

WELL LOCATION:
sec. 18 T. 8 N. R. 6 E.
miles of (distance) (direction) (nearest town)

WELL PURPOSE: drone
(home, irrigation, municipal, industrial)

- WELL COMPLETION DATA:
- (1) diameter (inches) 4"
 - (2) total depth (feet) 217'
 - (3) static water level (feet) 125 below top of ground.
 - (4) casing Plastic 2 1/2" (material) (depth)
4" (size) if telescope see back.
 - (5) screen 6' (length) 211' (depth to top)
4" (size) Plastic (material)
 - (6) pump ? (HP) ? (yield gpm)
Electric (type power)
 - (7) electric log No (yes or no)
(organization running log)
 - (8) how well bottom plugged wood plug

CODED


MAY 14 1968

MISSISSIPPI BOARD OF WATER COMMISSIONERS

DRILLERS REMARKS:

If well telescopes please sketch and show depths.

GROUND LEVEL

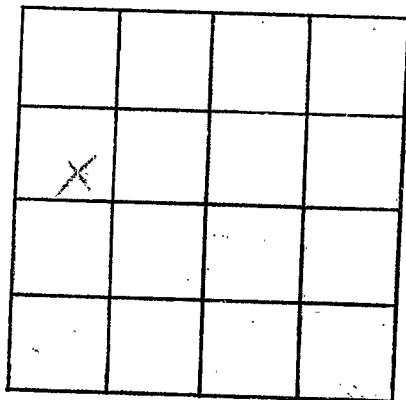

SECTION 18

Please indicate well location X.

ADDITIONAL INFORMATION

If more than one screen,
show locations of each on sketch.