

MISSISSIPPI
 BOARD OF WATER COMMISSIONERS
 416 North State Street
 Jackson, Mississippi 39201

CODED

WATER WELL DRILLERS LOG

Lincoln
B 15
1-3-69

Jan 3 1969 Fitzgould well Lincoln
 date well completed firm name county well located

LANDOWNER:

Billy Applewhite
RR. Cayserville, Miss.
 (mailing address)

description of formations encountered

from to

<u>Red clay</u>	<u>0</u>	<u>30</u>
<u>Red sand</u>	<u>30</u>	<u>75</u>
<u>Red sand & gravel</u>	<u>75</u>	<u>105</u>
<u>Fine Red sand</u>	<u>105</u>	<u>130</u>
<u>Fine sand & gravel</u>	<u>130</u>	<u>145</u>
<u>Coarse sand & gravel</u>	<u>145</u>	<u>156</u>

WELL LOCATION:

sec. 16 T. 8 N. R. 6 E.
4 miles SE of Cayserville
 (distance) (direction) (nearest town)

WELL PURPOSE:

Home
 (home, irrigation, municipal, industrial)

WELL COMPLETION DATA:

- (1) diameter (inches) 4"
- (2) total depth (feet) 156
- (3) static water level (feet) 90 below above top of ground.
- (4) casing Plastic 150'
 (material) (depth)
4" if telescope see back.
 (size)
- (5) screen 6' 150'
 (length) (depth to top)
4" Plastic
 (size) (material)
- (6) pump P ?
 (HP) (yield gpm)
elec.
 (type power)
- (7) electric log Yes
 (yes or no)
 (organization running log)
- (8) how well bottom plugged wood plug

DRILLERS REMARKS:


CODED

FEB 19 1969

MISS. BD. OF
 WATER COM.:

If well telescopes please sketch and show depths.

GROUND LEVEL

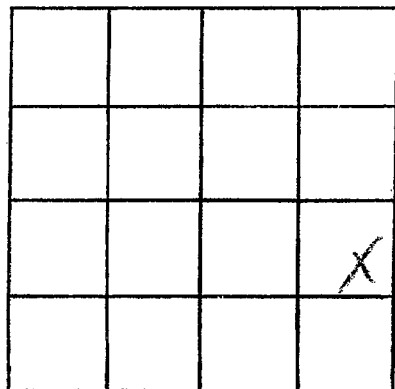

SECTION 16

Please indicate well location X.

ADDITIONAL INFORMATION

If more than one screen,
show locations of each on sketch.