

Lincoln
B 16
2-6-69

MISSISSIPPI
BOARD OF WATER COMMISSIONERS
416 North State Street
Jackson, Mississippi 39201

CODED

WATER WELL DRILLERS LOG

2-6-69 date well completed
1969 Higdonold Water Well firm name
Lincoln county well located

LANDOWNER: Walter B. Vaise
Brookhaven Rd Miss

description of formations encountered	from	to
Red clay	0	20
Red sand	20	80
Red sand & gravel	80	110
fine sand	110	150
coarse sand	150	160
coarse sand & gravel	160	170

(mailing address)

WELL LOCATION:

sec 17 T 8 N R 6 E
1 1/2 miles W of Brookhaven
(distance) (direction) (nearest town)

WELL PURPOSE: Home
(home, irrigation, municipal, industrial)

WELL COMPLETION DATA:

- (1) diameter (inches) 4
- (2) total depth (feet) 170
- (3) static water level (feet) 120 below top of ground.
- (4) casing plastic, 114
(material) (depth)
4 if telescope see back.
(size)
- (5) screen 6, 114
(length) (depth to top)
4, plastic
(size) (material)
- (6) pump 3/4, 15
(HP) (yield gpm)
Elec
(type power)
- (7) electric log No
(yes or no)
- (organization running log)
- (8) how well bottom plugged wood peg

CODED


FEB 13 1969

DRILLERS REMARKS:

MISS. Bd. OF
WATER COMMISSIONERS

If well telescopes please sketch and show depths.

GROUND LEVEL

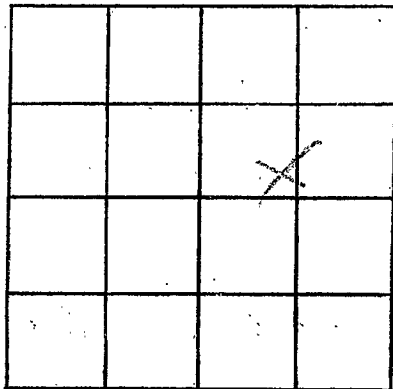

SECTION 17

Please indicate well location X.

ADDITIONAL INFORMATION

If more than one screen,
show locations of each on sketch.