

LINCOLN
B18
1-29-70

MISSISSIPPI
BOARD OF WATER COMMISSIONERS
416 North State Street
Jackson, Mississippi 39201

WATER WELL DRILLERS LOG

Jan. 29 1970 Green Water Well Cont. Lincoln
date well completed firm name county well located


LANDOWNER: Charles R. Britt	description of formations encountered	from	to
Route 1 Wesson, Miss. (mailing address)			
WELL LOCATION: sec. 2 T 8 N S R 6 E W 15. miles NW of Brookhaven (distance) (direction) (nearest town)	Hattiesburg-Pascagoula	115	160
WELL PURPOSE: Domestic - home (home, irrigation, municipal, industrial)	Fine Sand	160	250
WELL COMPLETION DATA: (1) diameter (inches) 6 in. (2) total depth (feet) 300 ft. (3) static water level (feet) 120 below top of ground. (4) casing plastic 260 (material) (depth) 4 in. (size) if telescope see back. (5) screen 40 ft. 260 ft. (length) (depth to top) .012 plastic (size) (material) (6) pump did not install (HP) (yield gpm) (type power) (7) electric log NO (yes or no) (organization running log) (8) how well bottom plugged wood	Medium Sand	250	300
DRILLERS REMARKS:			

FEB 18 1970

MISS. BD. OF
WATER COMM.

If well telescopes please sketch and show depths.

GROUND LEVEL

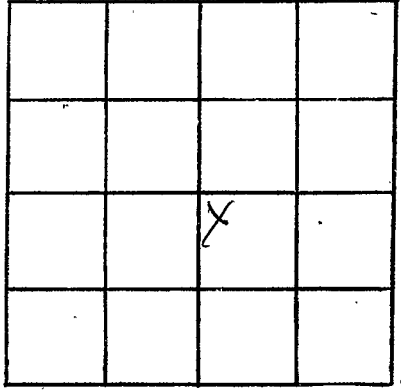

SECTION 2

Please indicate well location X.

ADDITIONAL INFORMATION

A series of horizontal lines for writing additional information, starting below the 'ADDITIONAL INFORMATION' header and extending to the bottom of the page.

If more than one screen, show locations of each on sketch.