

Lincoln
B 19
2-10-70

MISSISSIPPI
BOARD OF WATER COMMISSIONERS
416 North State Street
Jackson, Mississippi 39201

WATER WELL DRILLERS LOG

CODED

2-10 1970 Fitzgerald well serv Lincoln
date well completed firm name county well located

LANDOWNER:
Larry Wilson
RR. Coahoma, Miss.
(mailing address)

description of formations encountered	from	to
<u>Red clay</u>	<u>0</u>	<u>20</u>
<u>Red sand</u>	<u>20</u>	<u>70</u>
<u>Blue clay</u>	<u>70</u>	<u>130</u>
<u>Gravel</u>	<u>150</u>	<u>170</u>
<u>Coarse sand</u>	<u>170</u>	<u>178</u>

WELL LOCATION:
sec. 4 T. 8 N. R. 6 E
9 miles W of Brookhaven
(distance) (direction) (nearest town)

WELL PURPOSE: Home
(home, irrigation, municipal, industrial)

WELL COMPLETION DATA:

(1) diameter (inches) 4

(2) total depth (feet) 178

(3) static water level (feet) 100 below above top of ground.

(4) casing Plastic 170
(material) (depth)
4 if telescope see back.
(size)

(5) screen 2 170
(length) (depth to top)
4 Plastic
(size) (material)

(6) pump 3/4 12
(HP) (yield gpm)
Elm
(type power)

(7) electric log no
(yes or no)
(organization running log)

(8) how well bottom plugged across plug

CODED


FEB 27 1970

DRILLERS REMARKS:

MISS. BD. OF
WATER COMM.

If well telescopes please sketch and show depths.

GROUND LEVEL

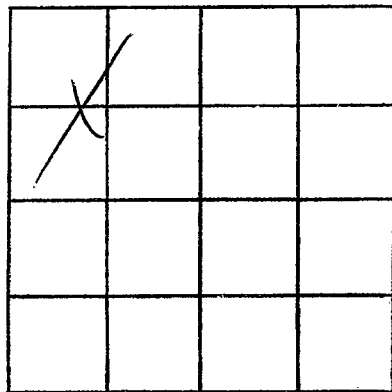

SECTION 4

Please indicate well location X.

ADDITIONAL INFORMATION

If more than one screen,
show locations of each on sketch.