

MISSISSIPPI
BOARD OF WATER COMMISSIONERS
416 North State Street
Jackson, Mississippi 39201

WATER WELL DRILLERS LOG

CODED

LINCOLN
B 20
8-18-70

Aug. 18 1970 Grenn Water Well Contr. Lincoln
date well completed firm name county well located

LANDOWNER:	description of formations encountered	from	to
Bennie Case			
Rt. 3, Brookhaven, Miss.	Pascagoula Clay	78	120
(mailing address)	Sand	120	194
WELL LOCATION:			
sec. 29 T 8 R 6			
10 miles WNW of Brookhaven			
(distance) (direction) (nearest town)			
WELL PURPOSE: home			
(home, irrigation, municipal, industrial)			
WELL COMPLETION DATA:			
(1) diameter (inches) 6"			
(2) total depth (feet) 194			
(3) static water level (feet) 120 below top of ground.			
(4) casing PVC 194' (material) (depth)			
4" (size) if telescope see back.			
(5) screen 4' 190' (length) (depth to top)			
.010 PVC (size) (material)			
(6) pump 3/4 sub. 7 (HP) (yield gpm)			
electric (type power)			
(7) electric log no (yes or no)			
(organization running log)			
(8) how well bottom plugged wood			
DRILLERS REMARKS:			


CODED

SEP 17 1970

MISS. BD. OF
WATER COMM.

If well telescopes please sketch and show depths.

GROUND LEVEL

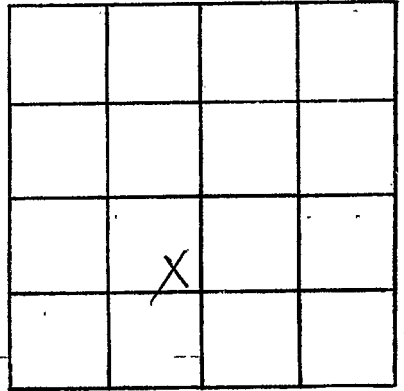

SECTION _____

Please indicate well location X.

ADDITIONAL INFORMATION

If more than one screen, show locations of each on sketch.