

Lincoln
B 21
6-25-70

MISSISSIPPI
BOARD OF WATER COMMISSIONERS
416 North State Street
Jackson, Mississippi 39201

CODED

WATER WELL DRILLERS LOG

Order 7/6/70
Rec'd 7/15/70

6-25 1970 date well completed
Green Water Well Co. firm name
Lincoln county well located

LANDOWNER:	description of formations encountered	from	to
Louis Durr R 3 Brookhaven (mailing address)	Citronelle	0	200
WELL LOCATION:			
sec. 28 T. 8 N. R. 6 E 11 miles WNW of Brookhaven (distance) (direction) (nearest town)			
WELL PURPOSE: Home (home, irrigation, municipal, industrial)			
WELL COMPLETION DATA:			
(1) diameter (inches) 6"			
(2) total depth (feet) 200			
(3) static water level (feet) 100 below top of ground.			
(4) casing PVC 175 (material) (depth)			
(size) if telescope see back.			
(5) screen 4' 171 (length) (depth to top)			
010 PVC (size) (material)			
(6) pump 3/4 Sub 7 (HP) (yield gpm)			
Elec. (type power)			
(7) electric log no (yes or no)			
(organization running log)			
(8) how well bottom plugged Wood			
DRILLERS REMARKS:			


CODED

III 2 1970

MISS. BD. OF
WATER COM.

If well telescopes please sketch and show depths.

GROUND LEVEL

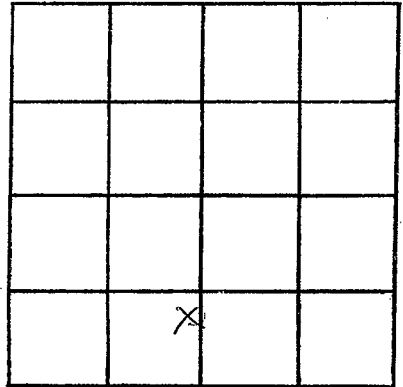

SECTION 28

Please indicate well location X.

ADDITIONAL INFORMATION

If more than one screen,
show locations of each on sketch.