

LINCOLN
B22
12-10-70

MISSISSIPPI
BOARD OF WATER COMMISSIONERS
416 North State Street
Jackson, Mississippi 39201

CODED

WATER WELL DRILLERS LOG

Dec. 10 1970 Grenn Water Well Contractor Lincoln
date well completed firm name county well located

| LANDOWNER: Gene Strait Bouie Mill Rd. Brookhaven, Miss. (mailing address) | description of formations encountered | from | to |
|---|---------------------------------------|------|-----|
| | Citronelle | 0 | 40 |
| | Pascagoula | 40 | 120 |
| | Hattiesburg | 120 | 210 |
| | Sand | 210 | 248 |
| | clay | 248 | 300 |
| WELL LOCATION: | | | |
| sec. 35 T 8 N R 6 E 9 miles of Brookhaven (distance) (direction) (nearest town) | | | |
| WELL PURPOSE: home (home, irrigation, municipal, industrial) | | | |
| WELL COMPLETION DATA: | | | |
| (1) diameter (inches) 6" | | | |
| (2) total depth (feet) 300 | | | |
| (3) static water level (feet) 115 below top of ground. | | | |
| (4) casing PVC 244 (material) (depth) 4" if telescope see back. (size) | | | |
| (5) screen 4' 244 (length) (depth to top) .010 PVC (size) (material) | | | |
| (6) pump did not install (HP) (yield gpm) (type power) | | | |
| (7) electric log no (yes or no) (organization running log) | | | |
| (8) how well bottom plugged wood | | | |
| DRILLERS REMARKS: | | | |


CODED

JAN 13 1971

MISS. Bd of WATER COM.

If well telescopes please sketch and show depths.

GROUND LEVEL

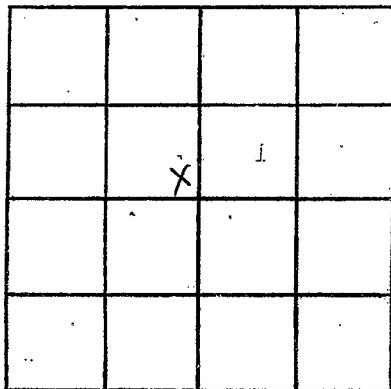

SECTION 35

Please indicate well location X.

ADDITIONAL INFORMATION

If more than one screen,
show locations of each on sketch.