

Lincoln Co
 B23
 1-21-71

MISSISSIPPI
 BOARD OF WATER COMMISSIONERS
 416 North State Street
 Jackson, Mississippi 39201

CODED

WATER WELL DRILLERS LOG

Jan. 21 1971 Green Water Well Cont. Lincoln
 date well completed firm name county well located

LANDOWNER: Ira Vazey Vazey
644 Passeland Pkwy
Tarohan La. 70123
 (mailing address)

description of formations encountered	from	to
Citronelle	0	34
Pascagoula	34	170
Sand	170	260

WELL LOCATION:
 sec. 24 T. 8 N. R. 6 E
 S. W. NW Brookhaven
 8 miles of (distance) (direction) (nearest town)

WELL PURPOSE: home
 (home, irrigation, municipal, industrial)

- WELL COMPLETION DATA:
- (1) diameter (inches) 6"
 - (2) total depth (feet) 260
 - (3) static water level (feet) 90 below above top of ground.
 - (4) casing PVC, 229 (material), (depth)
4" (size) if telescope see back.
 - (5) screen 4', 229 (length), (depth to top)
.010, PVC (size), (material)
 - (6) pump 1/2 Sub. 7 (HP), (yield gpm)
electric (type power)
 - (7) electric log no (yes or no)

CODED

(organization running log)

(8) how well bottom plugged wood


FEB 3 1971

DRILLERS REMARKS:

MISS. BD. OF
 WATER COMM.

If well telescopes please sketch and show depths.

GROUND LEVEL

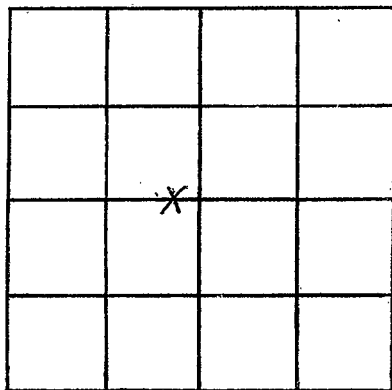

SECTION 24

Please indicate well location X.

ADDITIONAL INFORMATION

If more than one screen,
show locations of each on sketch.