

LINCOLN  
#B25

MISSISSIPPI BOARD OF WATER COMMISSIONERS

AK 212  
**CODED**

WATER WELL DRILLERS LOG

11-16-60

Date: 11/16, 1960, Driller: E.B. Jones County: Lincoln  
(Name)

(1) Owner of Land: Joe Norton  
(Name)

Box 194 Wesson  
(Address)

(2) Location: 1/4, 1/4, Sec. 12 T. 8 N. R. 6  
\_\_\_\_\_ miles \_\_\_\_\_ of \_\_\_\_\_  
(distance) (direction) (Nearest Town)

(3) Topography: \_\_\_\_\_  
(Hilly) (Flat) (Level)

(4) Purpose of Well: Domestic  
(Domestic Irrigation  
Municipal, Industrial, Other)

Description & Color of Materials Sand, Clay, Red Clay, Shell, etc.	Thick- ness Feet	Depth Feet
Brown Clay	0	10
Red Sand Clay	10	18
Sand & Gravel	18	78
Blue Clay	78	90
Blue Clay	90	145
Sand with Clay	145	175
Strata		
Sand	175	200

Information upon completion of well:

(1) Diameter 6 1/2 inches.

(2) Total Depth ~~200~~ 200 feet.

(3) Water Level 100 feet below top of ground.

(4) Cased to ~~200~~ 200 feet, Size 4"

(5) Screen: Size \_\_\_\_\_, Length \_\_\_\_\_


(6) Were any formations sealed against pollution?  
\_\_\_\_\_ yes,  no.

If YES depth of formation \_\_\_\_\_

Why \_\_\_\_\_

Drillers Remarks: I will  
and locate  
water -

**CODED**

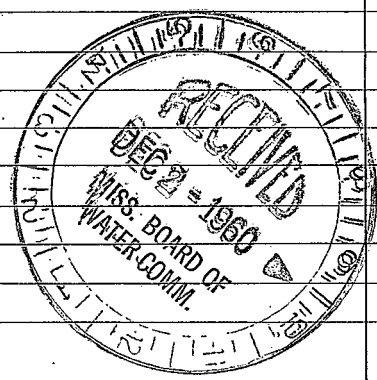

(Use Back Side)

Well No.

[The page contains extremely faint and illegible text, likely bleed-through from the reverse side of the document. The text is scattered across the page and cannot be transcribed accurately.]