

LINCOLN
B26
4-18-72

MISSISSIPPI
 BOARD OF WATER COMMISSIONERS
 416 North State Street
 Jackson, Mississippi 39201

CODED

WATER WELL DRILLERS LOG

April 18 1972 Grenville Cont Lincoln
 date well completed firm name county well located

LANDOWNER:	description of formations encountered	from	to
<u>Elmer Cokerham</u>	<u>Red sand & Clay</u>	<u>0</u>	<u>35</u>
<u>Rt 1 Box 150</u>	<u>Clay</u>	<u>35</u>	<u>148</u>
<u>Wesson, Miss.</u>	<u>Sand</u>	<u>148</u>	<u>160</u>
(mailing address)	<u>Clay</u>	<u>160</u>	<u>190</u>
WELL LOCATION:	<u>Sand</u>	<u>190</u>	<u>235</u>
sec <u>30T 8N</u> R <u>6E</u>	<u>Clay</u>	<u>235</u>	<u>260</u>
<u>8</u> miles <u>W</u> of <u>Brookhaven</u>			
(distance) (direction) (nearest town)			
WELL PURPOSE: <u>home</u>			
(home, irrigation, municipal, industrial)			
WELL COMPLETION DATA:			
(1) diameter (inches) <u>6"</u>			
(2) total depth (feet) <u>260</u>			
(3) static water level (feet) <u>120</u> below above top of ground.			
(4) casing <u>PVC</u> , <u>229</u> , (material) (depth)			
<u>4"</u> (size) if telescope see back.			
(5) screen <u>6'</u> , <u>229</u> (length) (depth to top)			
<u>1010</u> , <u>PVC</u> (size) (material)			
(6) pump <u>Did not install</u> (HP) (yield gpm)			
(type power)			
(7) electric log <u>no</u> (yes or no)			
(organization running log)			
(8) how well bottom plugged <u>wood</u>			
DRILLERS REMARKS:			


CODED

APR 18 1972

MISSISSIPPI BOARD OF WATER COMMISSIONERS

If well telescopes please sketch and show depths.

GROUND LEVEL

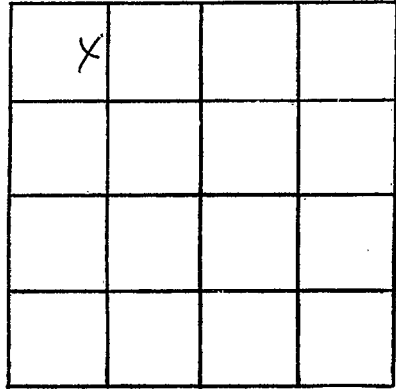

SECTION 30

Please indicate well location X.

ADDITIONAL INFORMATION

If more than one screen,
show locations of each on sketch.