

LINCOLN

B 28

9-19-73

MISSISSIPPI BOARD OF WATER COMMISSIONERS
416 North State Street
Jackson, Mississippi 39201

CODED

WATER WELL DRILLERS LOG

14 Sept 1973 J.T. Conington & Son Lincoln
date well completed firm name county well located

LANDOWNER:

F. Wall

Lead Star

(mailing address)

WELL LOCATION:

sec. 35 T. 8 N. R. 6 E
3 miles W of Lead Star
(distance) (direction) (nearest town)

WELL PURPOSE:

(home, irrigation, municipal, industrial)

WELL COMPLETION DATA:

- (1) diameter (inches) 4
- (2) total depth (feet) 274
- (3) static water level (feet) 100 below top of ground.
- (4) casing (material) PL (depth) 268
(size) If telescope see back.
- (5) screen (length) 6 (depth to top) 268
(size) 4 (material) PL
- (6) pump (HP) 1/2 (yield gpm) 8
(type power) elect
- (7) electric log (yes or no)

(organization running log)

(8) how well bottom plugged *Good*

description of formations encountered

from to

Clay	0	20
clay	20	80
Sand, shale	80	100
Clay	100	240
Sand	240	274

CODED


NET 9 A 1073

DRILLERS REMARKS:

MISS. BD. OF
WATER COMMISSIONERS

If well telescopes please sketch and show depths.

GROUND LEVEL

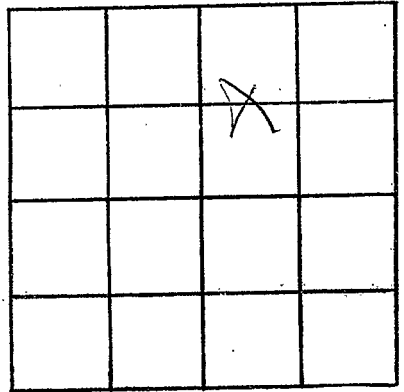

SECTION 35

Please indicate well location X.

ADDITIONAL INFORMATION

If more than one screen, show locations of each on sketch.