


Lincoln  
B30  
6-4-74

MISSISSIPPI  
BOARD OF WATER COMMISSIONERS  
416 North State Street  
Jackson, Mississippi 39201

COPIED


WATER WELL DRILLERS LOG

June 4, 1974 Grenn Water Well Lincoln  
date well completed firm name county well located

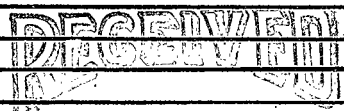LANDOWNER: Gary Norton	description of fomations encountered	from	to
Route 3, Box 33 C Brookhaven, Miss. (mailing address)			
<b>WELL LOCATION:</b>			
sec. 22 T 8 N R 6 E S W			
8 miles NW of Brookhaven (distance) (direction) (nearest town)			
<b>WELL PURPOSE:</b> home (home, irrigation, municipal, industrial)			
<b>WELL COMPLETION DATA:</b>			
(1) diameter (inches) 6"			
(2) total depth (feet) 76'			
(3) static water level (feet) 48 below top of ground			
(4) casing PVC, 70' (material) (depth) 4" (size) if telescope see back.			
(5) screen 6' (length), 70' (depth to top) .010 PVC (size) (material)			
(6) pump did not install (HP) (yield gpm) (type power)			
(7) electric log no (yes or no) (organization running log)			
(8) how well bottom plugged wood			
<b>DRILLERS REMARKS:</b>			
 OCT 25 1974 MISS. BD. OF WATER COMM.			

If well telescopes please sketch and show depths.

GROUND LEVEL

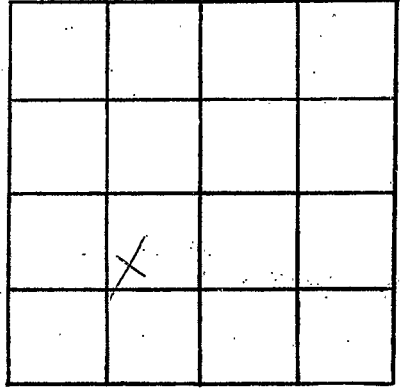

SECTION 22

Please indicate well location X.

ADDITIONAL INFORMATION

Lined area for additional information.

If more than one screen, show locations of each on sketch.