

Lincoln
B31
7-1-74

MISSISSIPPI
BOARD OF WATER COMMISSIONERS
416 North State Street
Jackson, Mississippi 39201

CODED

WATER WELL DRILLERS LOG

XXXXXX July 1974 Grenn Water Well Lincoln
date well completed firm name county well located


LANDOWNER:	description of formations encountered	from	to
Clayton Callender	Citronelle	0	83
Rt. 1, Box 225			
Wesson, Miss. (mailing address)			
WELL LOCATION:			
sec. 22 T 8 N R 6 E			
10 miles NW of Brookhaven			
(distance) (direction) (nearest town)			
WELL PURPOSE: home			
(home, irrigation, municipal, industrial)			
WELL COMPLETION DATA:			
(1) diameter (inches) 6"			
(2) total depth (feet) 83'			
(3) static water level (feet) 65' below above ground			
(4) casing PVC 77' (material) (depth)			
4" If telescope see back. (size)			
(5) screen 6' 77' (length) (depth to top)			
.010 PVC (size) (material)			
(6) pump 1/3 HP Sub 7 (HP) (yield gpm)			
electric (type power)			
(7) electric log no (yes or no)			
(organization running log)			
(8) how well bottom plugged wood			
DRILLERS REMARKS:			

RECEIVED
OCT 25 1974

MISS. BD. OF WATER COMMISSIONERS

If well telescopes please
sketch and show depths.

GROUND LEVEL

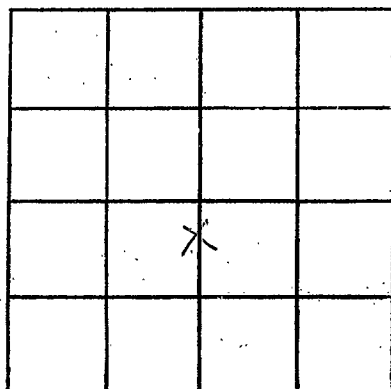

SECTION 22

Please indicate well location X.

ADDITIONAL INFORMATION

If more than one screen,
show locations of each on sketch.