

Lincoln
 B32
 6-4-74

MISSISSIPPI
 BOARD OF WATER COMMISSIONERS
 416 North State Street
 Jackson, Mississippi 39201

CODED

WATER WELL DRILLERS LOG

June 4

1974 Green Water Well

Lincoln

date well completed

firm name

county well located

LANDOWNER:

John Blanchard

Route 1, Wesson, Miss.

(mailing address)

description of formations encountered

Citronelle

from

to

0

73

WELL LOCATION:

sec. 32 T 8 N R 6 E
 S X X

12 miles NW of Brookhaven
 (distance) (direction) (nearest town)

WELL PURPOSE: home

(home, irrigation, municipal, industrial)

WELL COMPLETION DATA:

- (1) diameter (inches) 6"
- (2) total depth (feet) 73'
- (3) static water level (feet) 59 below top of ground.
- (4) casing PVC 67 (material), (depth)
 4" (size) if telescope see back.
- (5) screen 6' 67 (length), (depth to top)
 .010 PVC (size) (material)
- (6) pump 1/3 Sub 7 (HP) (yield gpm)
 electric (type power)
- (7) electric log no (yes or no)

(organization running log)


(8) how well bottom plugged 1 word

DRILLERS REMARKS:

25 1974

If well telescopes please sketch and show depths.

GROUND LEVEL

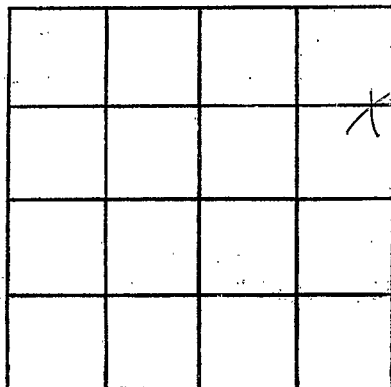

SECTION 32

Please indicate well location X.

ADDITIONAL INFORMATION

If more than one screen, show locations of each on sketch.