

LINCOLN
B 33
3-74

MISSISSIPPI
BOARD OF WATER COMMISSIONERS
416 North State Street
Jackson, Mississippi 39201

WATER WELL DRILLERS LOG

March 19 74 Chester Reines Lincoln
date well completed firm name county well located

LANDOWNER: Donald Gene Smith
RFD Brookhaven
(mailing address)

description of formations encountered	from	to
Red clay	0	16
Red chalky sand	16	47
Sand	47	65

WELL LOCATION:
sec. 25 T 8 N R 6 E 13 U
5 1/2 miles N.W. of Brookhaven
(distance) (direction) (nearest town)

WELL PURPOSE: Home
(home, irrigation, municipal, industrial)

WELL COMPLETION DATA:

- (1) diameter (inches) 4"
- (2) total depth (feet) 67
- (3) static water level (feet) 4' 2" above top of ground
- (4) casing Plast Bottom
(material) (depth)
- (5) screen 6' 6'
(length) (depth to top)
- (6) pump 1/2 Sub 1.5
(HP) (yield gpm)
- (7) electric log No
(yes or no)

If telescope see back.
(size)

4" Plast
(size) (material)

Elect
(type power)

(organization running log)

(8) how well bottom plugged
wood chips


DRILLERS REMARKS:
New house

CODED

RECEIVED
FEB 12 1975

If well telescopes please sketch and show depths.

GROUND LEVEL

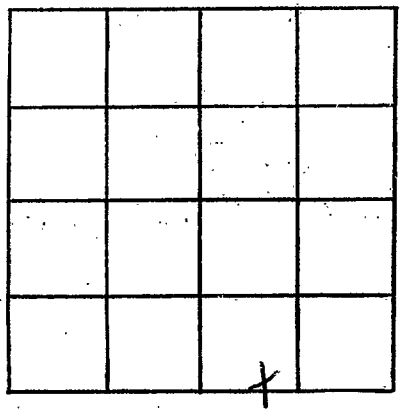

SECTION 207

Please indicate well location X.

ADDITIONAL INFORMATION

Lined area for additional information.

If more than one screen, show locations of each on sketch.