

Lincoln  
 B 36  
 7-15-75

MISSISSIPPI  
 BOARD OF WATER COMMISSIONERS  
 416 North State Street  
 Jackson, Mississippi 39201

CODED

WATER WELL DRILLERS LOG

July 15 1975 Grem Water Well Contr. Lincoln  
 date well completed firm name county well located

LANDOWNER:	description of formations encountered	from	to
Shell Oil Co. Microwave Tower	Clay	1	12
Union Church, Miss. (mailing address)	Sand & gravel Clay	12 83	83 150
WELL LOCATION: sec. 22 T 8 N R 6 E 14A 3 miles E of Caseyville (distance) (direction) (nearest town)	Fine sand Sand	150 165	165 192
WELL PURPOSE: Industrial (home, irrigation, municipal, industrial)			
WELL COMPLETION DATA:			
(1) diameter (inches) 6"			
(2) total depth (feet) 192			
(3) static water level (feet) 125 below top of ground.			
(4) casing PVC 180 (material) (depth) 4" (size) If telescope see back.			
(5) screen 12' 180' (length) (depth to top) .010 PVC (size) (material)			
(6) pump 1 Sub. 25 (HP) (yield gpm) electric (type power)			
(7) electric log no (yes or no) (organization running log)			
(8) how well bottom plugged wood			
DRILLERS REMARKS:			


RECEIVED  
 SEP 10 1975

MISS. BD. OF WATER COMMISSIONERS



If well telescopes please sketch and show depths.

GROUND LEVEL

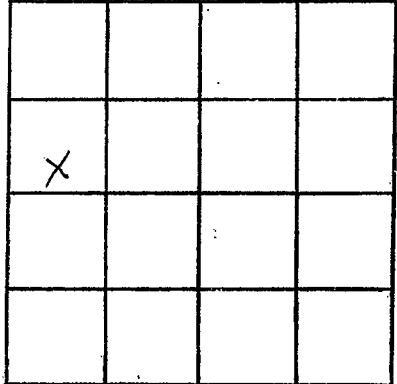

SECTION 22

Please indicate well location X.

ADDITIONAL INFORMATION

Lined area for additional information

If more than one screen, show locations of each on sketch.